Pd #150 7-1-96 M.B. Form 61854

IREDELL COUNTY HEALTH DEPARTMENT

STATESVILLE 704-878-5305 MOORESVILLE 704-664-5281

IMPROVEMENT PERMIT / CERTIFICATE OF COMPLETION / OPERATION PERMIT / EXISTING SYSTEM INSPECTION

PROPERTY DESCRIPTION NO. 24033 DATE 6-22-96 TAX MAP NO. 5K-A-16 Pt of Watershed: ☐ Yes ☐ No

OWNER OR CONTRACTOR Tim McCoy PHONE: Business 873-1481 Home

ADDRESS 2016 N.S.L. Drive Pt Olit Town mt

LOCATION NE TR Nabors Rd 3/4 mi left

SUBDIVISION BLOCK / SECTION LOT LOT AREA .592 acres SITE CLASS. PS DESIGN FLOW 360 L.T.A.R. 13

Septic Tank: 1000 Gallons; STB 794 Date 3-7-96
Pump Tank: Gallons; PT Date
Pump Make: Model Serial No.
Nitrification Field: No Fields 1 Square Feet 900 Linear Feet 300
No Lines 5 Trench Width 36" Max Trench Bottom Depth 36" Gravel Depth N/A

☐ New System ☐ Repair System Type: I. II. III. IV. V. VI
System Description: Gravity Infiltrator
Repair System Description: " "
Maintenance Agreement Required: ☐ Yes ☐ No


☐ House/Mod. Home No. Bedrooms 3
☐ Mobile Home No. Bathrooms 2
☐ Business No. Employees
☐ Other
☐ Slab ☐ Crawl Space ☐ Basement w/plumbing ☐ Basement wo/plumbing

Water Supply: ☐ Individual ☐ Community ☐ Public

Comments:

Comments:

INITIAL SITE SKETCH

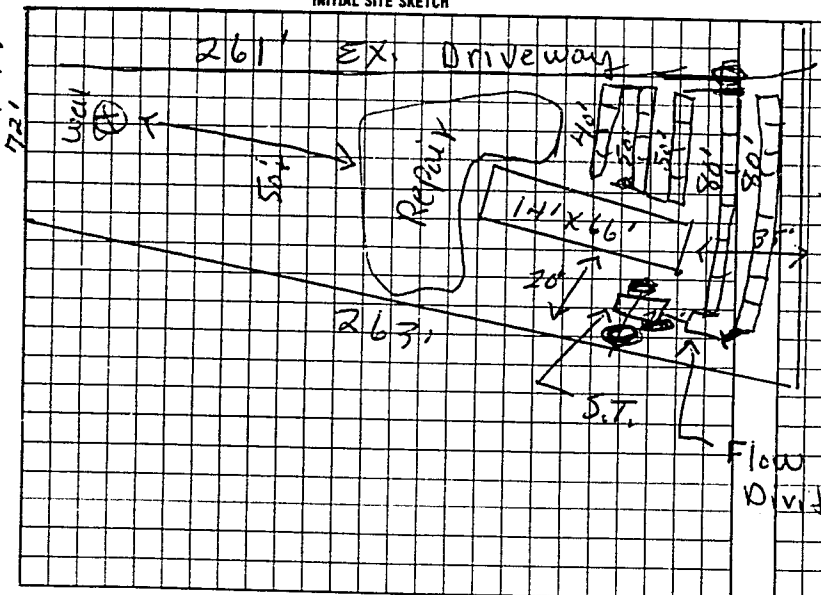

AS BUILT SKETCH

Same as initial sketch

I understand that this permit can be suspended or revoked if any false information is supplied toward securing the permit/any unauthorized changes are made to the site/any unauthorized changes are made in the installation of the system.

Signed: Tim McCoy

Improvement Permit by: D.C. Moore date 6-22-96

Existing System Inspected by: D.C. Moore date 6-22-96 to cover.

Installed by: A-1 Backhoe

Certificate of Completion by: date

Operation Permit by: D.C. Moore date 7-7-96

Authorization to Const. Expires 60 mos from issue

HEALTH DEPT COPY WHITE — OWNER COPY (FINAL) GREEN — OWNER COPY (FINAL) YELLOW — INSPECTION COPY (INITIAL) PINK — OWNER COPY (INITIAL) BLUE