IREDELL COUNTY HEALTH DEPARTMENT

STATESVILLE 704-878-5305 (cl) MOORESVILLE 704-664-5281

IMPROVEMENT PERMIT / AUTHORIZATION TO CONSTRUCT / OPERATION PERMIT / EXISTING SYSTEM INSPECTION

PERMIT# 14060360V PIN# 4763-22-6446 DATE 3-14-07

OWNER OR APPLICANT LINDA S SHULENBERGER PHONE: Business 704-252-4501 Home 704-876-0371

ADDRESS 241 NABORS ROAD STATESVILLE, NC 28677

LOCATION US 70 EAST, TR NABORS ROAD, MH ON LEFT AT BOX #241

SUBDIVISION _____ BLOCK / SECTION _____ LOT _____ LOT AREA 0.876 ACRES SITE CLASS. PS DESIGN FLOW 360 L.T.A.R. 0.20 GPD/FT²

Septic Tank: EXISTING Gallons; STB _____ Date _____

Pump Tank: _____ Gallons; PT _____ Date _____

Pump Make: _____ Model _____ Serial No. _____

Nitrification Field: No Fields 1 Square Feet EXIST 640 Linear Feet 160

No Lines TWO Trench Width 36" Max Trench Bottom Depth 36" Gravel Depth N/A

☐ New System ☐ Repair ☑ Expansion System Type: I II III IV V VI

System Description: 25% REDUCTION GRAVITY

Repair System Description: 25% REDUCTION, GRAV.

Maintenance Agreement Required: ☐ Yes ☑ No

☐ Gravity ☐ Pressure

☐ House/Mod. Home No. Bedrooms 3

☑ Mobile Home No. Persons ____

☐ Business No. Employees ____

☐ Other _____


Water Supply: ☑ Individual ☐ Public ☐ Community WELL

☐ Slab ☑ Crawl Space ☐ Basement w/plumbing ☐ Basement wo/plumbing


Comments:/Conditions: EXPAND SYSTEM AS SHOWN USING 25% REDUCTION DRAINLINES WITH ONE NEW DROP BOX AT LOCATION SHOWN.

Comments:/Conditions:

INITIAL SITE SKETCH ~ SCALE: 1"=50'

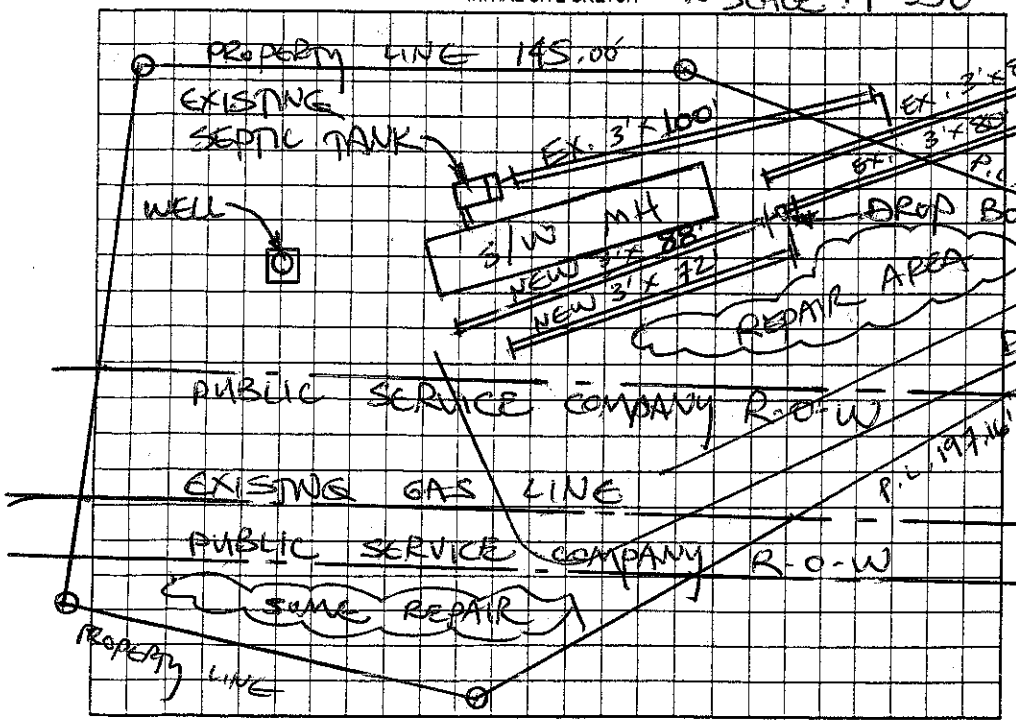

AS BUILT SKETCH

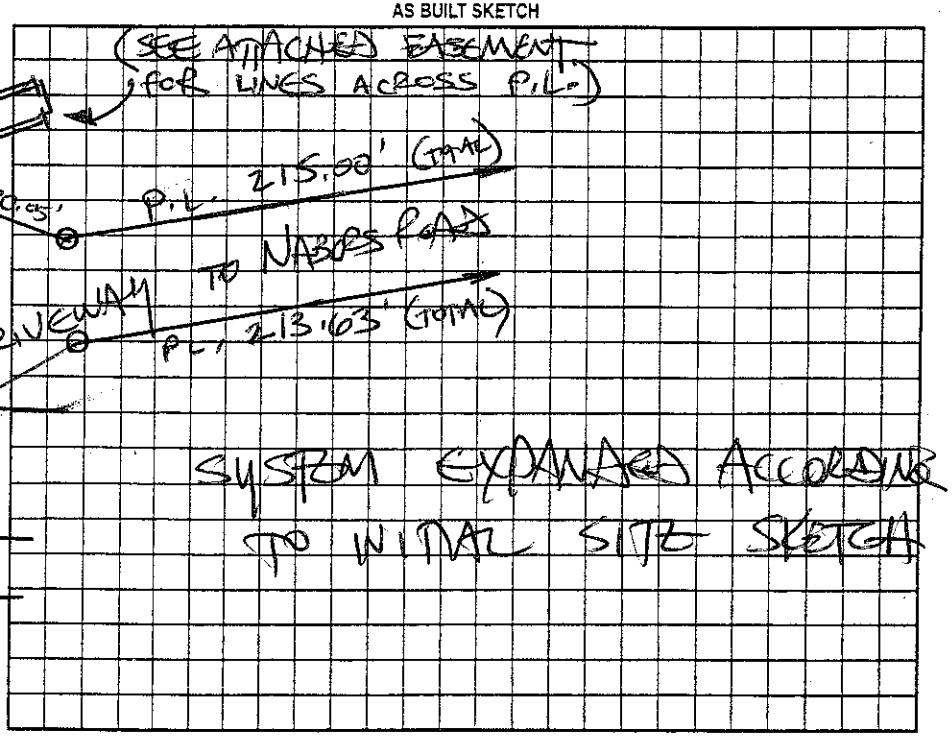

Permit can be suspended or revoked if any false information is supplied toward securing the permit/any unauthorized changes are made to the site/any unauthorized changes are made in the installation of the system. Improvement Permit with plat valid without expiration ☐ Improvement Permit with site plan valid for sixty months ☑ Authorization to Construct is valid for a period equal to that of Improvement Permit – not to exceed sixty months.

Signed: Linda S. Shulenberger date 3-15-07

Improvement Permit by: STEVE HENDRICK date 3-14-07

Authorization to Construct by: STEVE HENDRICK date 3-14-07

Installed by: A-1 BACKHOE

Operation Permit by: STEVE HENDRICK date 3-26-07

Existing System Inspection by: _____ date _____

HEALTH DEPT. COPY: WHITE OWNER COPY (FINAL): YELLOW OWNER COPY (INITIAL): PINK