IREDELL COUNTY HEALTH DEPARTMENT

STATESVILLE 704-878-5305 MOORESVILLE 704-664-5281

IMPROVEMENT PERMIT / CERTIFICATE OF COMPLETION / OPERATION PERMIT / EXISTING SYSTEM INSPECTION

PROPERTY DESCRIPTION NO. 25504 DATE 12-13-96 TAX MAP NO. 5K-A-78 pt Watershed: ☐ Yes ☑ No

OWNER OR CONTRACTOR Linda Gosforth PHONE: Business _____ Home 838 0285

ADDRESS 241 Nabors Rd

LOCATION 70 E TR Nabors Rd 3/4 mi left

SUBDIVISION _____ BLOCK / SECTION _____ LOT _____ LOT AREA 1.9 acres SITE CLASS. 6 PS DESIGN FLOW 240 L.T.A.R. .25

Septic Tank: 1000 Gallons; STB 1012 Date 2-13-97

Pump Tank: _____ Gallons; PT _____ Date _____

Pump Make: _____ Model _____ Serial No. _____

Nitrification Field: No Fields 1 Square Feet 1260 Linear Feet 420

No Lines 3 Trench Width 36" Max Trench Bottom Depth 36" Gravel Depth NA

☑ New System ☐ Repair System Type: I, II, III, IV, V, VI

System Description: Gravity chambers

Repair System Description: " "

Maintenance Agreement Required: ☐ Yes ☑ No

☐ House/Mod. Home No. Bedrooms 2

☑ Mobile Home No. Bathrooms 2

☐ Business No. Employees ____

☐ Other _____


☐ Slab ☑ Crawl Space ☐ Basement w/plumbing ☐ Basement wo/plumbing

Water Supply: ☑ Individual ☐ Community ☐ Public


Comments:

Comments:
Push
* Extra Dirt overends at 80ft
Divert water runoff around lines

INITIAL SITE SKETCH

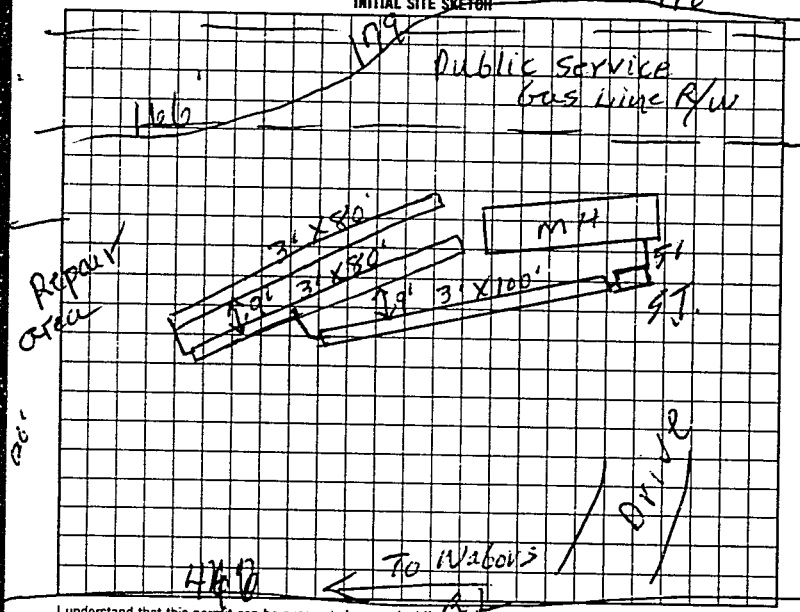

AS BUILT SKETCH

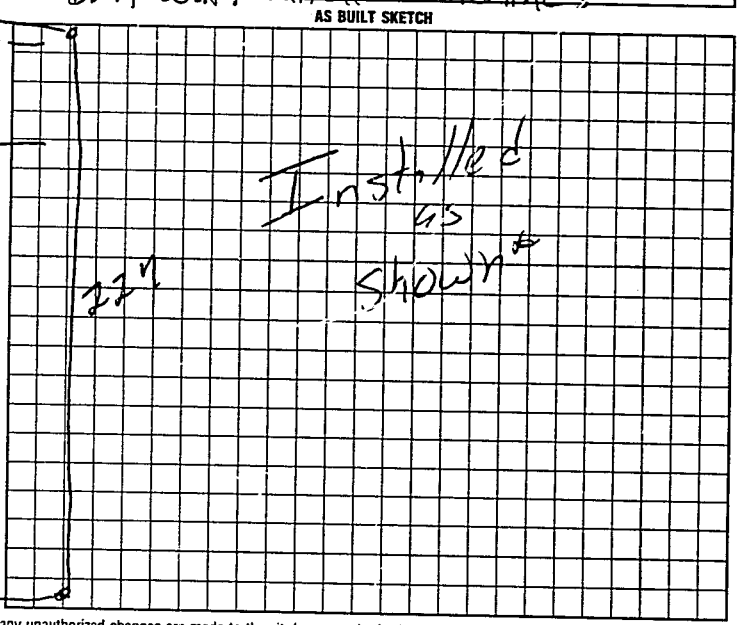

I understand that this permit can be suspended or revoked if any false information is supplied toward securing the permit/any unauthorized changes are made to the site/any unauthorized changes are made in the installation of the system. Improvement Permit is valid for 60 months from date of issuance.

Signed: Linda Gosforth

Improvement Permit by: E. C. Moore date 12-13-96

Existing System Inspection by: Authorization to Const. E. C. Moore date 12-13-96

Installed by: Donald Lucky

Certificate of Completion by: _____ date _____

Operation Permit by: Mark Clark date 1997

HEALTH DEPT. COPY: WHITE INSPECTION COPY (FINAL): GREEN OWNER COPY (FINAL): YELLOW INSPECTION COPY (INITIAL): PINK OWNER COPY (INITIAL): GOLD

Authorization to Const Expires 6 mo from issue

12000