IREDELL COUNTY HEALTH DEPARTMENT

STATESVILLE 704-878-5305 MOORESVILLE 704-664-5281

IMPROVEMENT PERMIT / AUTHORIZATION TO CONSTRUCT / OPERATION PERMIT / EXISTING SYSTEM INSPECTION

PERMIT# 142418 PIN# 4763-22-8034 DATE 6-6-07

OWNER OR APPLICANT JAMES & DORIS NUNN PHONE: Business Home 704-596-0409

ADDRESS 4800 WILD ROSE LANE CHARLOTTE, NC 28269

LOCATION US 70 EAST, TR NABORS ROAD, 0.7 MILE ON LEFT

SUBDIVISION BLOCK / SECTION LOT LOT AREA 4.05 ACRES SITE CLASS. PS DESIGN FLOW 360 L.T.A.R. 0.30 GPD/FT²

Septic Tank: 1000 Gallons; STB 1012 Date 2-15-07
Pump Tank: Gallons; PT Date
Pump Make: Model EQ. PF 1200 Serial No.
Nitrification Field: No Fields 1 Square Feet Linear Feet 300
No Lines FIVE Trench Width 36" Max Trench Bottom Depth 36"

☑ New System ☐ Repair ☐ Expansion System Type: I II III IV V VI
System Description: 25% REDUCTION, GRAVITY
Repair System Description: 25% REDUCTION, GRAVITY
Maintenance Agreement Required: ☐ Yes ☑ No
Gravel Depth N/A ☑ Gravity ☐ Pressure


☑ House/Mod. Home No. Bedrooms 3
☐ Mobile Home No. Persons
☐ Business No. Employees
☐ Other
☐ Slab ☑ Crawl Space ☐ Basement w/plumbing ☐ Basement wo/plumbing

Water Supply: ☑ Individual ☐ Public ☐ Community WELL

Comments/Conditions: ① KEEP SYSTEM MINIMUM 100' FROM WELL
② INSTALL 25% REDUCTION SYSTEM ON CONTOUR

Comments/Conditions: SEPTIC TANK WITH MARKER INSTALLED USING "TUFFITE" FILLER

INITIAL SITE SKETCH

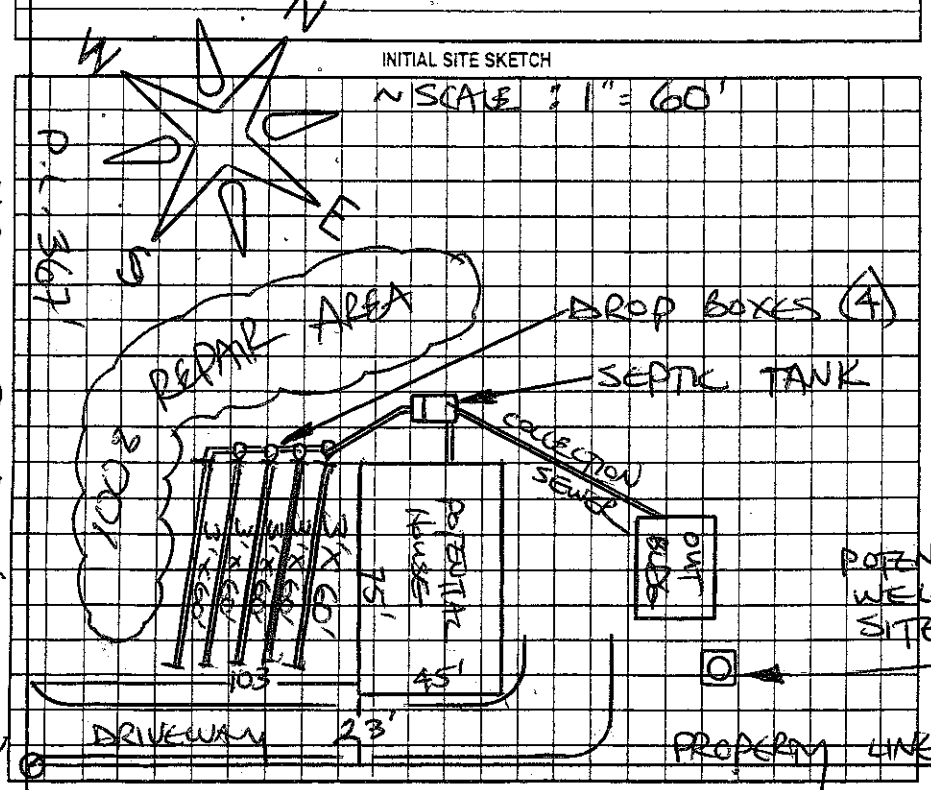

AS BUILT SKETCH

SYSTEM INSTALLED ACCORDING TO INITIAL SITE SKETCH

NABORS ROAD (SR 2357)

Permit can be suspended or revoked if any false information is supplied toward securing the permit/any unauthorized changes are made to the site/any unauthorized changes are made in the installation of the system. Improvement Permit with plat valid without expiration ☐ Improvement Permit with site plan valid for sixty months ☑ Authorization to Construct is valid for a period equal to that of Improvement Permit – not to exceed sixty months.

Signed: [signature] date 6-6-07 Installed by: A-1 BACKHOE

Improvement Permit by: STEVE HEDRICK date 6-6-07 Operation Permit by: STEVE HEDRICK date 7-31-07

Authorization to Construct by: STEVE HEDRICK date 7-20-07 Existing System Inspection by: date

HEALTH DEPT. COPY: WHITE OWNER COPY (FINAL): YELLOW OWNER COPY (INITIAL): PINK