IREDELL COUNTY HEALTH DEPARTMENT

STATESVILLE 704-878-5305 MOORESVILLE 704-664-5281

IMPROVEMENT PERMIT / CERTIFICATE OF COMPLETION / OPERATION PERMIT / EXISTING SYSTEM INSPECTION

PROPERTY DESCRIPTION NO. Repair DATE 6-4-97 TAX MAP NO. Repair Watershed: ☐ Yes ☐ No

OWNER OR CONTRACTOR Chapel Hill Meth. Church PHONE: Business 873-4464 Home

ADDRESS 119 Bethsda Rd

LOCATION Corner of 70E and Bethsda Rd Across from Wayside Egg Store

SUBDIVISION BLOCK / SECTION LOT LOT AREA SITE CLASS. P/S DESIGN FLOW 400 L.T.A.R. 0.3

Septic Tank: 1000 Gallons; STB Date

Pump Tank: Existing Gallons; PT Date

Pump Make: Model Serial No.

Nitrification Field: No Fields 1 Square Feet Linear Feet 330

No Lines 3 Trench Width 36in Max Trench Bottom Depth 36in Gravel Depth Sand

☐ New System ☒ Repair System Type: I, II, (III) IV, V, VI

System Description:

Repair System Description: Gravity Chambers

Maintenance Agreement Required: ☐ Yes ☐ No

☐ Slab ☒ Crawl Space ☐ Basement w/plumbing ☐ Basement wo/plumbing

☐ House/Mod. Home No. Bedrooms

☐ Mobile Home No. Bathrooms

☐ Business No. Employees


☒ Other Church 80-100 mem

Water Supply: ☐ Individual ☐ Community ☒ Public


Comments: keep lines on contour 9ft on center

Comments:

INITIAL SITE SKETCH

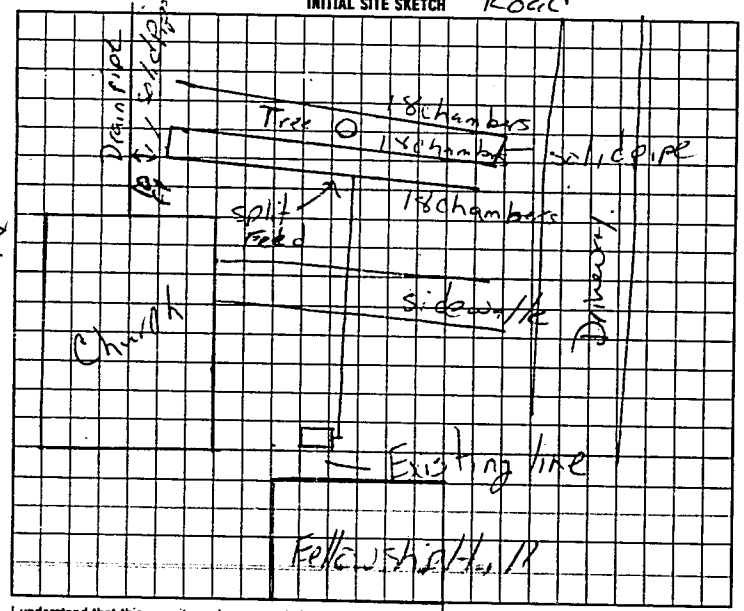

AS BUILT SKETCH

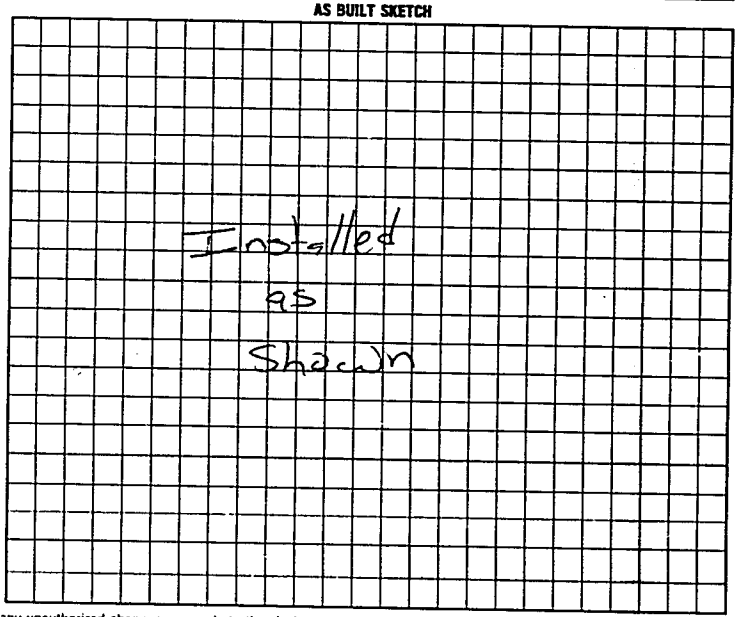

I understand that this permit can be suspended or revoked if any false information is supplied toward securing the permit/any unauthorized changes are made to the site/any unauthorized changes are made in the installation of the system. Improvement Permit is valid for 60 months from date of issuance.

Signed: Jerry L Eudy

Improvement Permit by: Mary C. Oates date 6-4-97

Existing System Inspection by: Mary C. Oates date 6-4-97

Installed by: David Yontz

Certificate of Completion by: date

Operation Permit by: Mary C. Oates date 7-22-97

HEALTH DEPT. COPY: WHITE INSPECTION COPY (FINAL): GREEN OWNER COPY (FINAL): YELLOW INSPECTION COPY (INITIAL): PINK OWNER COPY (INITIAL): GOLD

Rds d

8 1 1 0 0 0