11-12-10

IREDELL COUNTY HEALTH DEPARTMENT

STATESVILLE 704-878-5305 (R) (A) MOORESVILLE 704-664-5281

IMPROVEMENT PERMIT / AUTHORIZATION TO CONSTRUCT / OPERATION PERMIT / EXISTING SYSTEM INSPECTION

PERMIT # 16320 PIN # 4763-24-6826 DATE 9-13-10

OWNER or APPLICANT (1st Choice Home) Wm. E. FREELAND PHONE: Business 704 902 7308 Home:

OWNER or APPLICANT ADDRESS 119 Beechnut Lane, Statesville, NC

LOCATION / DIRECTIONS 2378 Salisbury Hwy

SUBDIVISION n/a BLOCK / SECTION n/a LOT # n/a LOT AREA 3.99 DESIGN FLOW 360 L.T.A.R. .25

Septic Tank 1000 Gallons STE Date

Pump Tank Gallons PT Date

Pump Make Model Serial #

Nitrification Field No Fields 1 No Lines 4 Linear Feet 360'

Trench Width 36" Max. Trench Bottom Depth 30" Gravel Depth n/a GRAVITY PRESSURE

☒ New System ☐ Repair ☐ Expansion System Type I II (III) IV V VI

System Description: 25% Reduction Gravity

Repair System Description: 25% Reduction Gravity

Maintenance Agreement Required ☐ YES ☒ NO

☒ Residence No. Bedrooms 3 ☐ Business No. Persons ☐ Other No. Employees ☐ Slab ☒ Crawl Space ☐ Basement w/plumbing ☐ Basement w/o plumbing

Water Supply: ☒ Private ☐ Public ☐ Community

Comments / Conditions


Maintain minimum setback

1" = 100'

218'


25' from all part of foundation (porch, stairs, building) to existing well

INITIAL SITE SKETCH

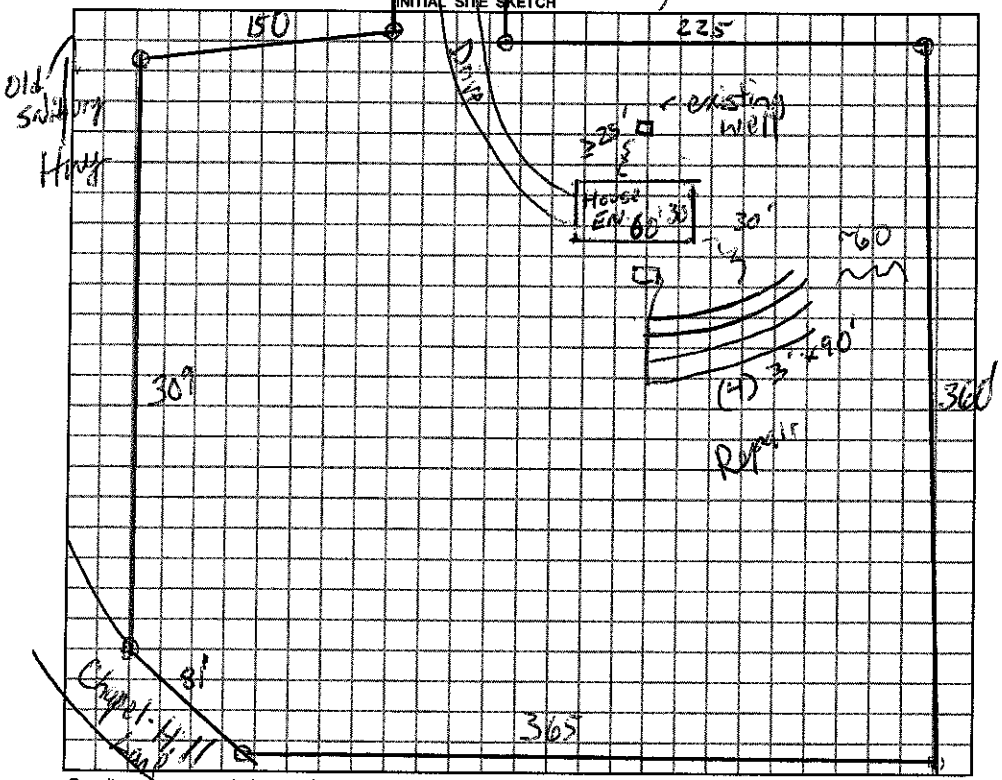

Comments / Conditions

AS BUILT SKETCH

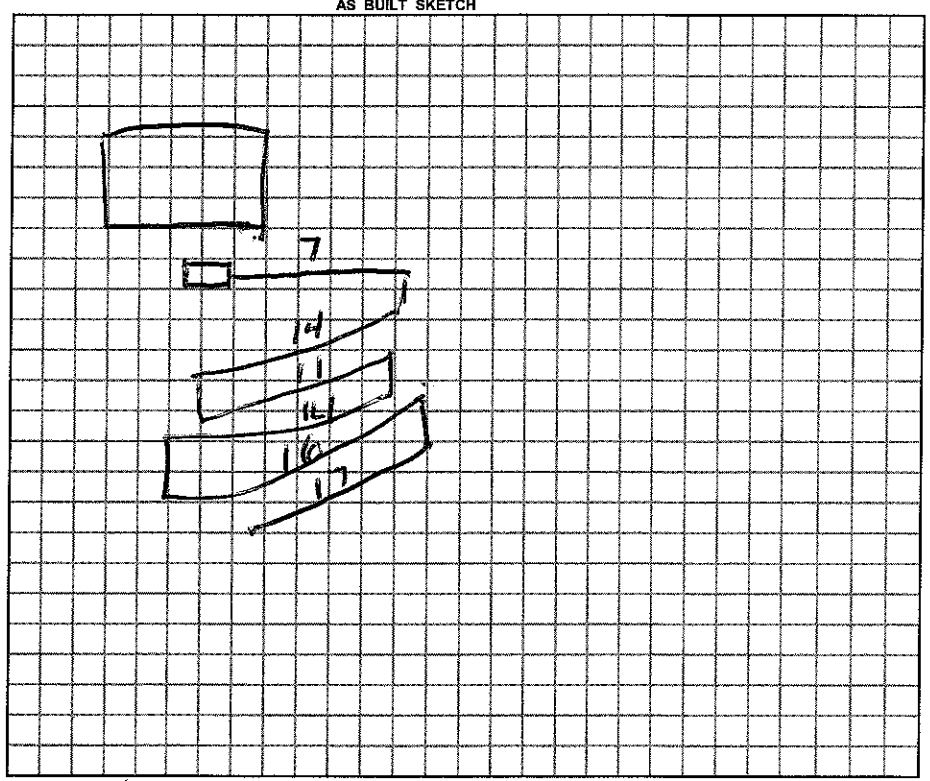

Permit can be suspended or revoked if any false information is supplied toward securing the permit / any unauthorized changes are made to the site / any unauthorized changes are made in the installation of the system.

☐ IMPROVEMENT PERMIT w / plan valid without expiration ☒ IMPROVEMENT PERMIT w / site plan valid for 60 mos. ☐ AUTHORIZATION TO CONSTRUCT valid for period equal to IMPROVEMENT PERMIT-not to exceed 60 mo.

Owner / Applicant Signature: Date 9-14-10

Improvement Permit by: Date 9-13-10

Authorization to Construct by: Date 9-13-10

YOU SHOULD CONTACT A LOCATOR SERVICE PRIOR TO ANY EXCAVATION.

Installed by: A-1 Backhoe

Operation Permit by: Date: 10-15-10

Existing System Inspected by: Date:

WHITE COPY Environmental Health YELLOW COPY (Final) Owner / Applicant PINK COPY (Initial) Owner / Applicant