IREDELL COUNTY HEALTH DEPARTMENT

Statesville Phone TR 3-7271 Mooresville Phone NO 3-1271

PERMIT TO INSTALL SEPTIC TANK

Permit NO. _____ Permit Date Dec 3 19 65

Owner Wayside Gro. Address R7 -

Installed By C Hoke Address _____


Location of Property Gulf Sta. & gro. at wayside

Tank		Capacity		Length of Lines		Fixtures	
Block	( )	800	( )	150'	( )	No. of Baths	( )
Precast	(—)	900	( )	175'	( )	Dishwasher	( )
		1000	(+)	200'	( )	Garbage Grdr.	( )
		1100	( )	225'	(+)	Auto-Washer	( )
		1200	( )	250'	( )	Other Market	
		Other _____		Other _____			

NOTIFY HEALTH DEPARTMENT AT LEAST EIGHT HOURS BEFORE TANK IS TO BE INSPECTED.

Final Inspection 12-3 1965 Approved (+) Disapproved ( )

Remarks No well on property at this time

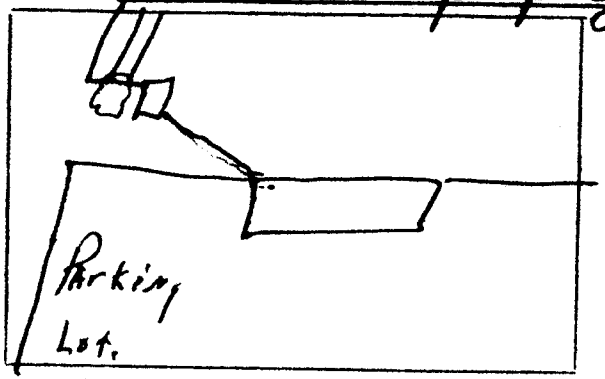

Sketch of Installation

RA

Sanitarian