IREDELL COUNTY HEALTH DEPARTMENT - *ENVIRONMENTAL HEALTH* ☑ STATESVILLE OFFICE 704-878-5305 ☐ MOORESVILLE OFFICE 704-664-5281

IMPROVEMENT PERMIT / AUTHORIZATION TO CONSTRUCT @/ OPERATION PERMIT @/ EXISTING SYSTEM INSPECTION

PERMIT # 16402i PIN # 4763-32-7745 DATE 12-8-10

OWNER ~~Allison Ramsey~~ WAYSIDE VFD APPLICANT: Wayside VFD PHONE: Home/Cell # 704-252-7277 Business #

SITE ADDRESS Bethesda Rd. OWNER / APPLICANT ADDRESS Bethesda

SITE DIRECTIONS Hwy 70, (R) Bethesda, on (R) across from Red Walnut Dr.

SUBDIVISION n/a BLOCK / SECTION n/a LOT # n/a LOT AREA 12.6 Ac. DESIGN FLOW 820 gpd L.T.A.R. .25

Septic Tank 1500 Gallons: STB 1500 Date 3-14-11

Pump Tank 1500 Gallons: P T 1530 Date 4-28-11

Pump Make Zoeller Model N-1405 Serial #

No. Nitrification Fields: 1 No. Lines 6 Linear Feet 820 total

Trench Width 36" Max. Trench Bottom Depth 36" Gravel Depth n/a

☑ New System ☐ Repair ☐ Expansion System Type I II (III) IV V VI

System Description: 25% Reduction Pump

Repair System Description: 25% Reduction Pump

Maintenance Agreement Required ☐ YES ☑ NO

☐ GRAVITY ☑ PRESSURE

☐ Residence No. Bedrooms

☑ Business No. Persons

☐ Other No. Employees 5

☑ Slab ☐ Crawl Space

☐ Basement w/plumbing ☐ Basement w/o plumbing

Water Supply: ☑ Private ☐ Public ☐ Community

Comments / Conditions

Blue Tuff-Tite Filter

INITIAL SITE SKETCH

See attached diagram for layout

AS BUILT SKETCH

Permit can be suspended or revoked if any false information is supplied toward securing the permit / any unauthorized changes are made to the site / any unauthorized changes are made in the installation of the system.

☐ ***IMPROVEMENT PERMIT*** *with plat valid without expiration.* ☑ ***IMPROVEMENT PERMIT*** *with plat valid without expiration.* ☑ ***AUTHORIZATION TO CONSTRUCT*** valid for period equal to IMPROVEMENT PERMIT–not to exceed 60 mo.

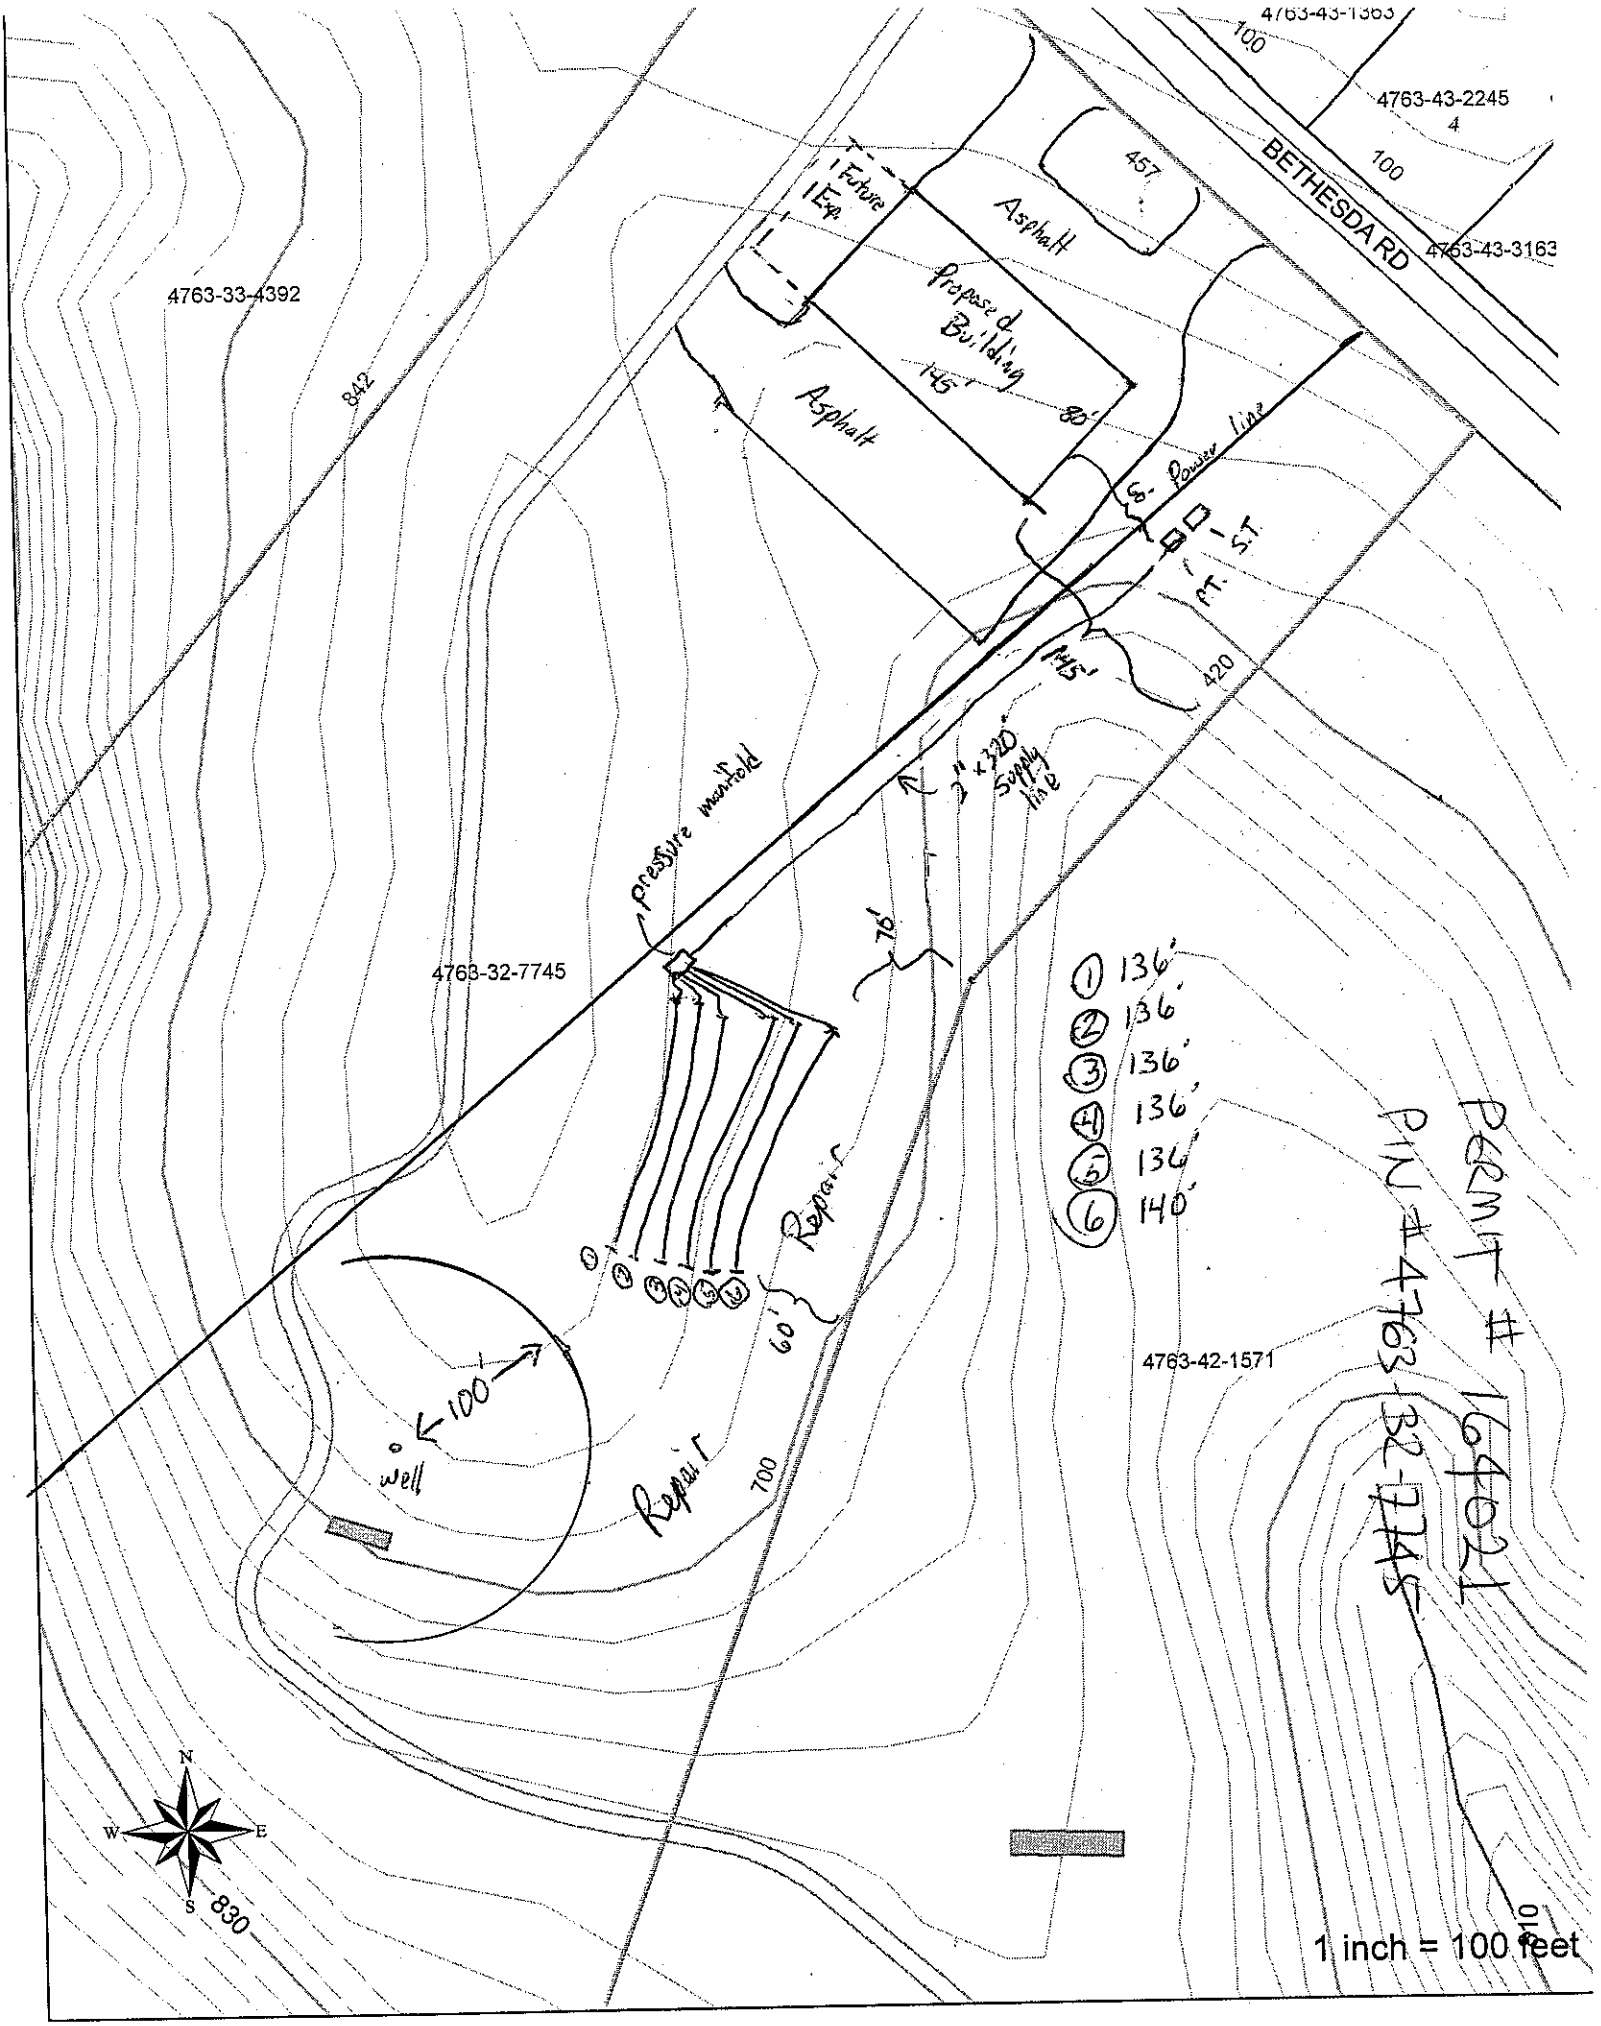
Owner / Applicant Signature: Date 12-10-2010 Installed by: Rowan Pope

IMPROVEMENT PERMIT by: REHS Date 12-8-10 OPERATION PERMIT by: REHS Date 9-29-11

AUTHORIZATION TO CONSTRUCT by: REHS Date 12-8-10 Existing System Inspected by: REHS Date

YOU SHOULD CONTACT A LOCATOR SERVICE PRIOR TO ANY EXCAVATION

White Copy – Environmental Health YELLOW COPY (Final) Owner / Applicant PINK COPY (Initial) Owner / Applicant


4763-43-1363
100
4763-43-2245
4
100
BETHESDA RD
4763-43-3163
457
Future Exp
Asphalt
Proposed Building
145'
80'
Asphalt
4763-33-4392
842
Ex. Power Line
S.T.
PT.
145'
420
2" x 320' Supply line
pressure manifold
4763-32-7745
75'
1 136'
2 136'
3 136'
4 136'
5 136'
6 140'
Repair
60'
100'
well
Repair
700
4763-42-1571
PERMIT # 164021
PIN # 4763-32-7745
N
W
E
S
830
1 inch = 100 feet