IREDELL COUNTY HEALTH DEPARTMENT

STATESVILLE 704-878-5305 MOORESVILLE 704-664-5281

IMPROVEMENT PERMIT / AUTHORIZATION TO CONSTRUCT / OPERATION PERMIT / EXISTING SYSTEM INSPECTION

PERMIT # 136296 PIN # 4763-33-8833 DATE 6-25-09

OWNER or APPLICANT Kenneth Wiecoff PHONE: Business Home:

OWNER or APPLICANT ADDRESS 112 Meadow Court Statesville 28677

LOCATION / DIRECTIONS 70 to Bethesda to Meadow Ct 2nd on right

SUBDIVISION Moose Cave Meadow BLOCK / SECTION LOT # 16 LOT AREA .4446 DESIGN FLOW 360 L.T.A.R. Bed

Septic Tank 1000 (Fiber) Gallons: STB Exist Date Exist

Pump Tank Gallons: P.T Date

Pump Make Model Serial #

Nitrification Field No Fields No Lines Linear Feet 240

Trench Width 36" Max. Trench Bottom Depth 10 36 Gravel Depth 12

☐ ~~New System~~ ☐ Repair ☐ Expansion System Type I II III IV V VI

System Description: Conventional Crawl

Repair System Description: 2550 Crawl

Maintenance Agreement Required ☐ YES ☑ NO

☐ GRAVITY ☐ PRESSURE


☐ Residence No. Bedrooms 3 ☐ Business No. Persons ☐ Other No. Employees ☐ Slab ☐ Crawl Space ☐ Basement w/plumbing ☐ Basement w/o plumbing

Water Supply: ☑ ~~Private~~ ☐ Public ☐ Community


Comments / Conditions

Comments / Conditions At time of inspection system flushing properly

INITIAL SITE SKETCH

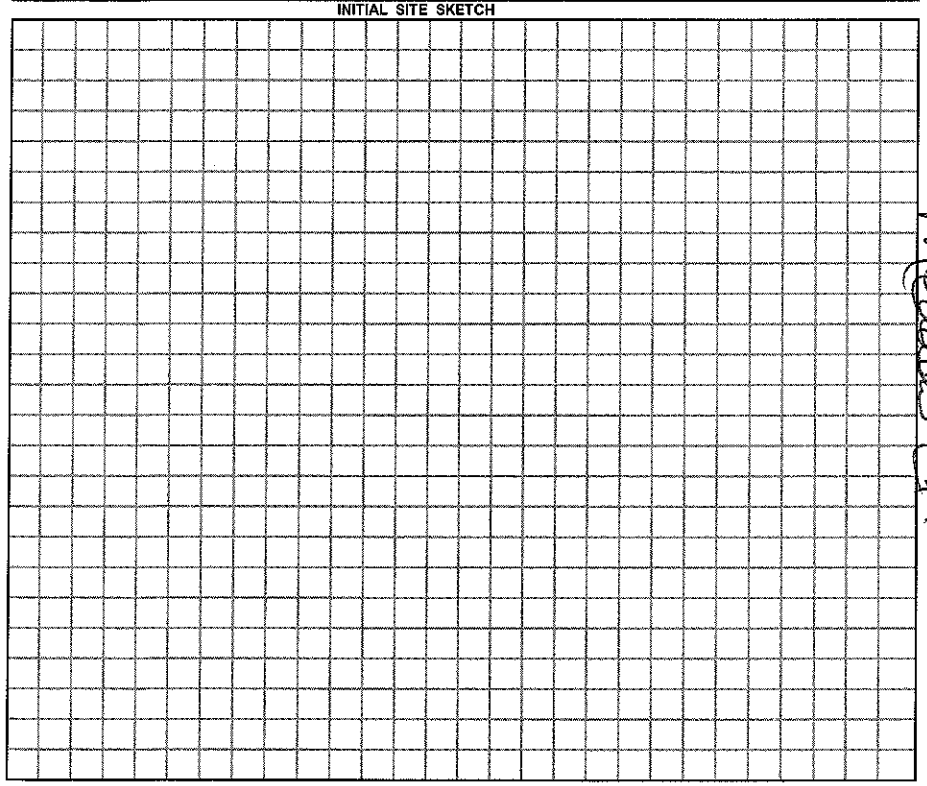

AS BUILT SKETCH

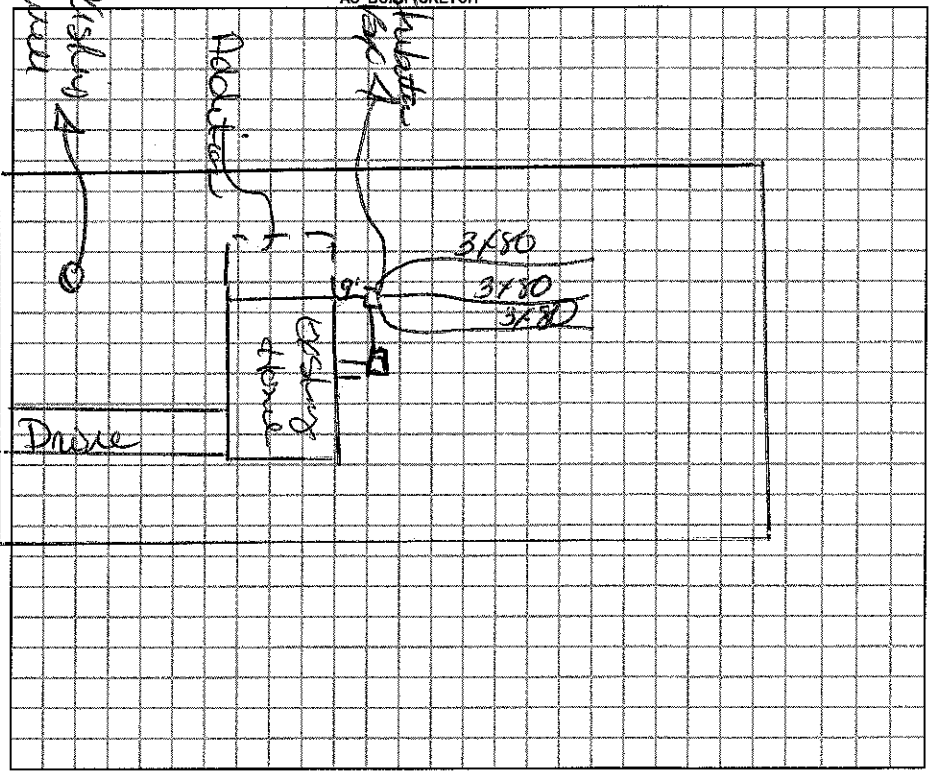

Permit can be suspended or revoked if any false information is supplied toward securing the permit / any unauthorized changes are made to the site / any unauthorized changes are made in the installation of the system.

☐ *IMPROVEMENT PERMIT w / plat valid without expiration.* ☐ *IMPROVEMENT PERMIT w / site plan valid for 60 mos.* ☑ *AUTHORIZATION TO CONSTRUCT valid for period equal to IMPROVEMENT PERMIT-not to exceed 60 mo.*

Owner / Applicant Signature: Date 6-26-09

Improvement Permit by: Date

Authorization to Construct by: Date

YOU SHOULD CONTACT A LOCATOR SERVICE PRIOR TO ANY EXCAVATION.

Installed by:

Operation Permit by: Date:

Existing System Inspected by: Date: 6-26-09

WHITE COPY Environmental Health YELLOW COPY (Final) Owner / Applicant PINK COPY (Initial) Owner / Applicant