IREDELL COUNTY HEALTH DEPARTMENT

STATESVILLE 704-878-5305 MOORESVILLE 704-664-5281

IMPROVEMENT PERMIT / AUTHORIZATION TO CONSTRUCT / OPERATION PERMIT / EXISTING SYSTEM INSPECTION

PERMIT# Repair PIN# DATE 4/3/01

OWNER OR CONTRACTOR FRANK AND DIANA DAVIDSON PHONE: Business Home

ADDRESS 118 MEADOW CT., STATESVILLE, NC

LOCATION 70 E ® BETHESDA © MEADOW COURT 2nd ON ®

SUBDIVISION BLOCK / SECTION LOT LOT AREA SITE CLASS PS DESIGN FLOW 240 GPD L.T.A.R.

Septic Tank: EXISTING Gallons: STB Date

Pump Tank: Gallons: PT Date

Pump Make: Model Serial No.

Nitrification Field: No Fields 1 Square Feet 720' Linear Feet 240'

No Lines 3 Trench Width 3 Max Trench Bottom Depth 36" Gravel Depth 12"

☐ New System ☒ Repair System Type: I (II) III IV V VI

System Description: CONVENTIONAL

Repair System Description: CONVENTIONAL

Maintenance Agreement Required: ☐ Yes ☒ No

☒ House/Mod. Home No. Bedrooms 2

☐ Mobile Home No. Bathrooms

☐ Business No. Employees

☐ Other


☐ Slab ☒ Crawl Space ☐ Basement w/plumbing ☐ Basement wo/plumbing

Water Supply: ☒ Individual ☐ Public ☐ Community

Comments/Conditions: ① REPAIR MUST BE COMPLETED WITHIN 30 DAYS ② INSTALL DRAINLINES UNIFORM AND ON CONTOUR ③ PUMP SEPTIC TANK PRIOR TO REPAIR INSTALLATION.

Comments/Conditions:

INITIAL SITE SKETCH

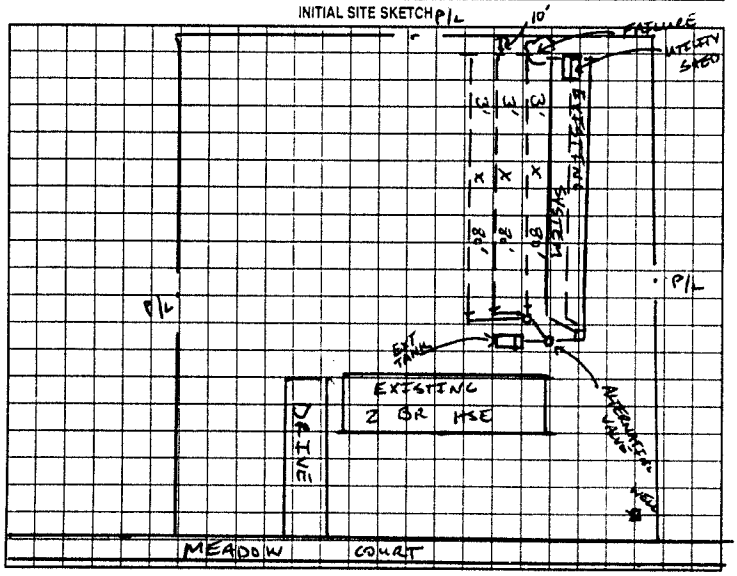

AS BUILT SKETCH

Installed as per Initial Site Sketch

Permit can be suspended or revoked if any false information is supplied toward securing the permit/any unauthorized changes are made to the site/any unauthorized changes are made in the installation of the system. Improvement Permit with plat valid without expiration. Improvement Permit with site plan valid for sixty months. Authorization to Construct is valid for a period equal to that of Improvement Permit – not to exceed sixty months.

Signed: date

Improvement Permit by: date 4/3/01

Authorization to Construct by: date 4/3/01

Installed by: Barry Stevens

Operation Permit by: William E. Johnson date 5/31/01

Existing System Inspection by: date

HEALTH DEPT COPY WHITE OWNER COPY (FINAL) YELLOW OWNER COPY (INITIAL) PINK