IREDELL COUNTY HEALTH DEPARTMENT

Statesville Phone TR 3-7271 Mooresville Phone NO 3-1271

PERMIT TO INSTALL SEPTIC TANK

Permit NO. _____ Permit Date APRIL 14 19 60

Owner JOHN HART Address RTD STATESVILLE

Installed By HOKE Address _____


Location of Property DOWN #70 EAST ~~LEFT~~ RIGHT BEYOND WAYSIDE SCHOOL 1 MILE ON RIGHT (COBLE PRODUCER)

Tank		Capacity		Length of Lines		Fixtures	
Block	( )	800	( )	150'	(✓)	No. of Baths	(1)
Precast	(✓)	900	(✓)	175'	( )	Dishwasher	( )
		1000	( )	200'	( )	Garbage Grdr.	( )
		1100	( )	225'	( )	Auto-Washer	( )
		1200	( )	250'	( )	Other	_____
		Other	_____	Other	_____		

NOTIFY HEALTH DEPARTMENT AT LEAST EIGHT HOURS BEFORE TANK IS TO BE INSPECTED.

Final Inspection APRIL 14 19 60 Approved (✓) Disapproved ( )

Remarks _____

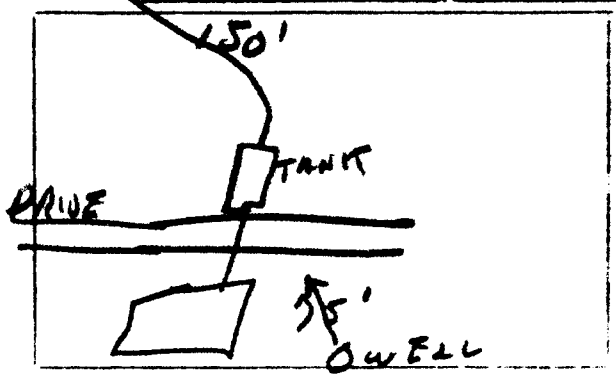

Sketch of Installation

Ralph A. Thomas

Sanitarian