IREDELL COUNTY HEALTH DEPARTMENT

Statesville Phone TR 3-7271 Mooresville Phone NO 3-1271

PERMIT TO INSTALL SEPTIC TANK

Permit NO. _____ Permit Date 4-14 1960

Owner John Hart Address Wayside

Installed By C. Hoke Address R.7.


Location of Property Right on Wayside go. farm on Right 2 miles

| Tank | Capacity | Length of Lines | Fixtures |
|---|---|---|---|
| Block ( ) | 800 ( ) | 150' (✓) | No. of Baths (✓) |
| Precast (✓) | 900 (✓) | 175' ( ) | Dishwasher ( ) |
| | 1000 ( ) | 200' ( ) | Garbage Grdr. ( ) |
| | 1100 ( ) | 225' ( ) | Auto-Washer ( ) |
| | 1200 ( ) | 250' ( ) | Other _____ |
| | Other _____ | Other _____ | |

NOTIFY HEALTH DEPARTMENT AT LEAST EIGHT HOURS BEFORE TANK IS TO BE INSPECTED.

Final Inspection 4-14 1960 Approved ( ) Disapproved ( )

Remarks Not for Washer - Well 75'

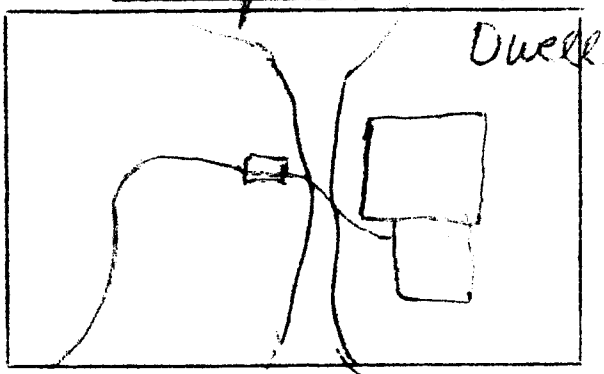


Sketch of Installation

Checked By C. Thomas

Sanitarian