11 30 6

# IREDELL COUNTY HEALTH DEPARTMENT

STATESVILLE 704-878-5305 MOORESVILLE 704-664-5281

## IMPROVEMENT PERMIT / AUTHORIZATION TO CONSTRUCT / OPERATION PERMIT / EXISTING SYSTEM INSPECTION

PERMIT# Repair PIN# 4743426464 DATE 10-8

OWNER OR APPLICANT Dorthy M. Sheldon PHONE: Business Home

ADDRESS 246 Bethabara Rd Statesville 28625

LOCATION 70 E @ Bethabara RD 1st house on right

SUBDIVISION BLOCK / SECTION LOT LOT AREA 2+ SITE CLASS B5 DESIGN FLOW 360 L.T.A.R. Repair

Septic Tank: 1000/1000 Gallons: STB Date

Pump Tank: Gallons: PT Date

Pump Make: Model Serial No.

Nitrification Field: No Fields Square Feet 1200 Linear Feet 800

No Lines 3 Trench Width 36" Max Trench Bottom Depth 36" Gravel Depth ☐ Gravity ☐ Pressure

☐ New System ☑ Repair ☐ Expansion System Type: I II III IV V VI

System Description: 3520 Conv'l

Repair System Description:

Maintenance Agreement Required: ☐ Yes ☐ No

☐ House/Mod. Home No. Bedrooms 3

☐ Mobile Home No. Persons

☐ Business No. Employees

☐ Other


Water Supply: ☐ Individual ☑ Public ☐ Community

☐ Slab ☐ Crawl Space ☐ Basement w/plumbing ☐ Basement wo/plumbing

Comments:/Conditions:

Comments:/Conditions: Maintain 15' off GAS line

INITIAL SITE SKETCH

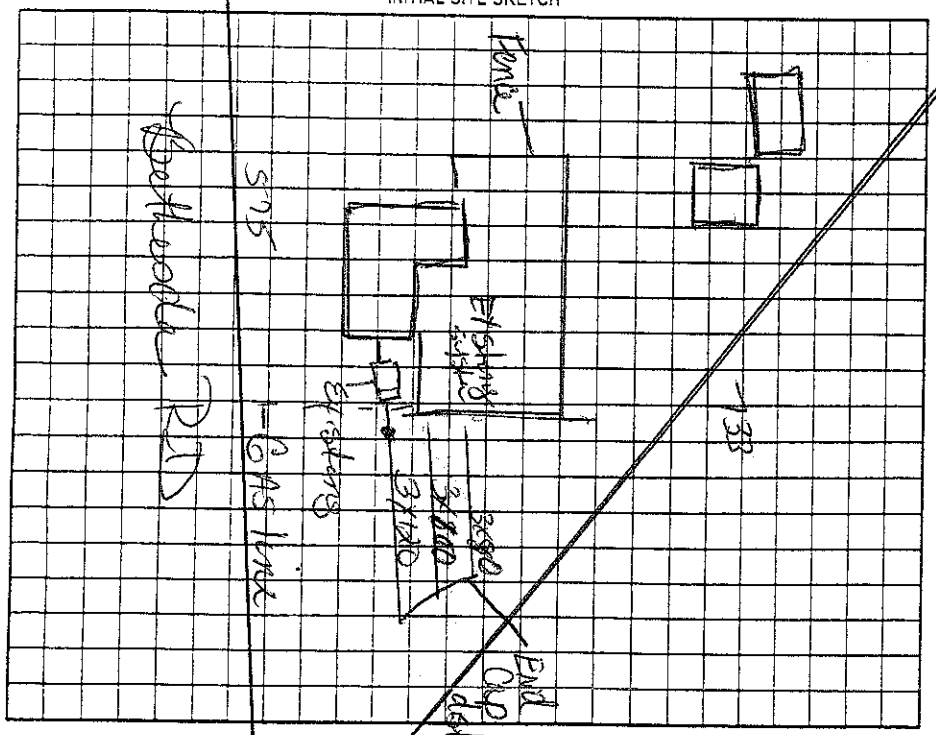


AS BUILT SKETCH

Permit can be suspended or revoked if any false information is supplied toward securing the permit/any unauthorized changes are made to the site/any unauthorized changes are made in the installation of the system. Improvement Permit with plat valid without expiration ☐ Improvement Permit with site plan valid for sixty months ☐ Authorization to Construct is valid for a period equal to that of Improvement Permit – not to exceed sixty months.

Signed: Dennis Gallihen date

Improvement Permit by: Kelly Cook date 10-9-07

Authorization to Construct by: Kelly Cook date 10-9-07

Installed by: A-1 Backhoe

Operation Permit by: date 10/10/07

Existing System Inspection by: date

HEALTH DEPT. COPY: WHITE OWNER COPY (FINAL): YELLOW OWNER COPY (INITIAL): PINK