IREDELL COUNTY HEALTH DEPARTMENT

STATESVILLE 704-878-5305 MOORESVILLE 704-664-5281

IMPROVEMENT PERMIT / CERTIFICATE OF COMPLETION / OPERATION PERMIT / EXISTING SYSTEM INSPECTION

PROPERTY DESCRIPTION NO. 21193 DATE 6-2-95 TAX MAP NO. 5K-4-A-60 Watershed: ☐ Yes ☒ No

OWNER OR CONTRACTOR T+T Inc. PHONE: Business 878 6660 Home

ADDRESS Po Box 1835 Statesville

LOCATION 70 E TR Bethesda Rd 1/4 mi left

SUBDIVISION Waysite Est. BLOCK / SECTION LOT 60 LOT AREA 3/4acre SITE CLASS. PS DESIGN FLOW 360 L.T.A.R. .3

Septic Tank: 1000 Gallons; STB 1012 Date 3-6-95

Pump Tank: Gallons; PT Date

Pump Make: Model Serial No.

Nitrification Field: No Fields 1 Square Feet 1200 Linear Feet 400

No Lines 5 Trench Width 36" Max Trench Bottom Depth 36" Gravel Depth 12"

☒ New System ☐ Repair System Type: I, (II) III, IV, V, VI

System Description: Conv. Gravity

Repair System Description: Gravity Corrus Black

Maintenance Agreement Required: ☐ Yes ☒ No Panel

☒ Slab ☐ Crawl Space ☐ Basement w/plumbing ☐ Basement wo/plumbing

☐ House/Mod. Home No. Bedrooms 3

☒ Mobile Home No. Bathrooms 2

☐ Business No. Employees


☐ Other

Water Supply:
☐ Individual
☐ Community
☒ Public


Comments:

Comments:

INITIAL SITE SKETCH

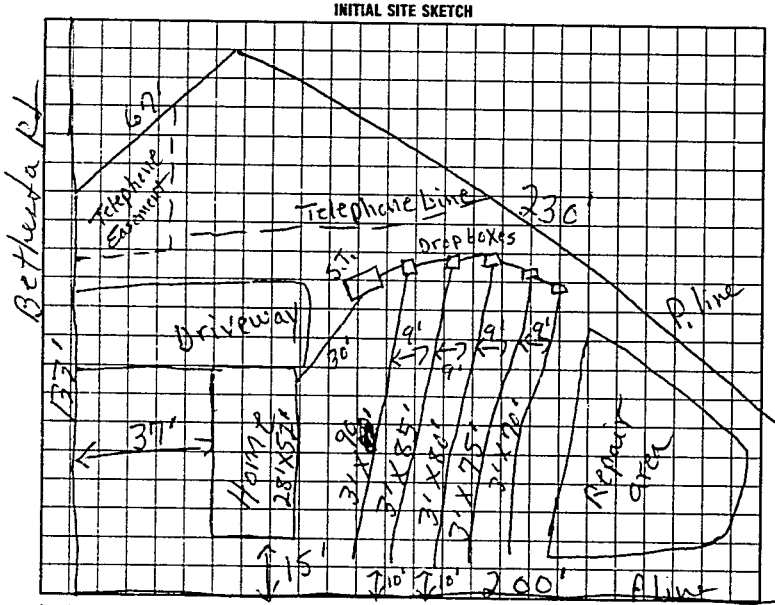

AS BUILT SKETCH

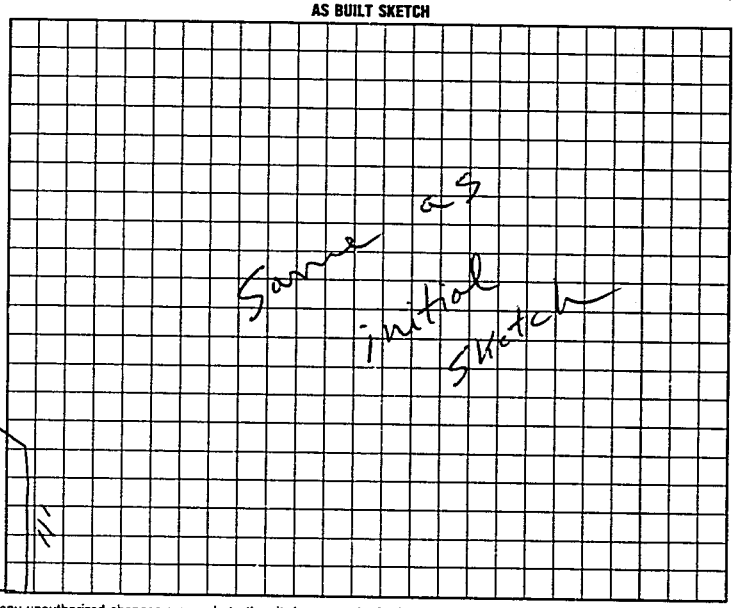

I understand that this permit can be suspended or revoked if any false information is supplied toward securing the permit/any unauthorized changes are made to the site/any unauthorized changes are made in the installation of the system. Improvement Permit is valid for 60 months from date of issuance.

Signed: T+T Co. D. Thaxton

Improvement Permit by: P. C. Moore date 6-2-95

Existing System Inspection by: date

Installed by: Donald Lackey

Certificate of Completion by: P. C. Moore date 6-12-95

Operation Permit by: date

HEALTH DEPT. COPY WHITE INSPECTION COPY (FINAL) GREEN OWNER COPY (FINAL) YELLOW INSPECTION COPY (INITIAL) PINK OWNER COPY (INITIAL) GOLD

1 0 0 2 0 0