IREDELL COUNTY HEALTH DEPARTMENT

STATESVILLE 704-878-5305 MOORESVILLE 704-664-5281

IMPROVEMENT PERMIT / AUTHORIZATION TO CONSTRUCT / OPERATION PERMIT / EXISTING SYSTEM INSPECTION

PERMIT# REPAIR PIN# L52-4763-42-9983 // 4763-52-0984-L-51 DATE 6-20-08

OWNER OR APPLICANT GENARO SANTIBANEZ PHONE: Business Home 704-902-7998

ADDRESS 130 BENTBROOK ROAD, STATESVILLE, NC 28677

LOCATION BETHESDA ROAD TO RED WALNUT DRIVE, TR CAMP OAK RD, TR BENTBROOK ROAD, 8TH LOT ON RIGHT

SUBDIVISION WAYSIDE EST. BLOCK / SECTION LOT 51/52 LOT AREA 200 x 180' SITE CLASS. PS DESIGN FLOW 360 L.T.A.R. 0.25GPD/FT2

Septic Tank: EXISTING Gallons: STB Date

Pump Tank: Gallons: PT Date

Pump Make: Model Serial No.

Nitrification Field: No Fields 1 Square Feet 1°288 Linear Feet 72'

No Lines ONE Trench Width 36" Max Trench Bottom Depth 36" Gravel Depth N/A

☑ New System ☑ Repair ☐ Expansion System Type: I II (III) IV V VI

System Description:

Repair System Description: 25% REDUCTION

Maintenance Agreement Required: ☐ Yes ☑ No

☐ House/Mod. Home ☑ Mobile Home ☐ Business ☐ Other


No. Bedrooms 3 No. Persons No. Employees

Water Supply: ☐ Individual ☑ Public ☐ Community

☑ Gravity ☐ Pressure ☐ Slab ☑ Crawl Space ☐ Basement w/plumbing ☐ Basement wo/plumbing

Comments/Conditions: INSTALL NEW SYSTEM ON CONTOUR DISTRIBUTION 25% REDUCTION USING SERIAL

INITIAL SITE SKETCH ~SCALE: 1"=40' (THIS IS NOT A SURVEY)

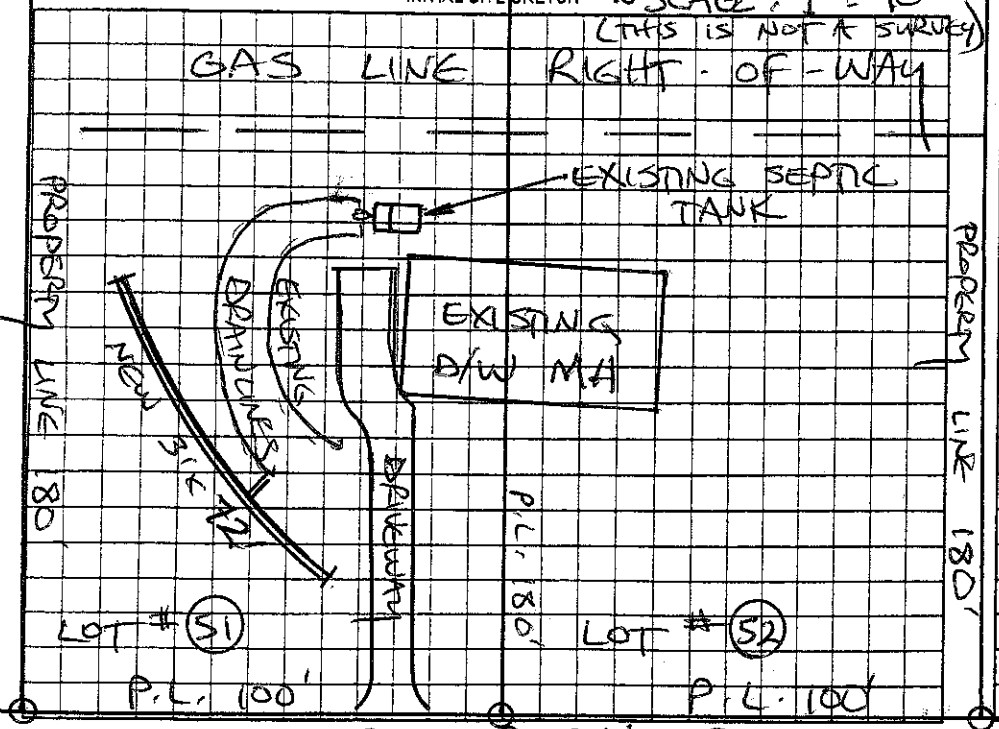

Comments/Conditions:

AS BUILT SKETCH

SYSTEM REPAIRED ACCORDING TO INITIAL SITE SKETCH

Permit can be suspended or revoked if any false information is supplied toward securing the permit, any unauthorized changes are made to the site/any unauthorized changes are made in the installation of the system. Improvement Permit with plat valid without expiration ☐ Improvement Permit with site plan valid for sixty months ☑ Authorization to Construct is valid for a period equal to that of Improvement Permit – not to exceed sixty months.

Signed: Genaro Santibanez date 6-20-08 Installed by: A-1 BACKHOE

Improvement Permit by: STEVE HENDRICK date 6-20-08 Operation Permit by: STEVE HENDRICK date 4-27-09

Authorization to Construct by: STEVE HENDRICK date 6-20-08 Existing System Inspection by: date

HEALTH DEPT. COPY: WHITE OWNER COPY (FINAL): YELLOW OWNER COPY (INITIAL): PINK