IREDELL COUNTY HEALTH DEPARTMENT

STATESVILLE 704-878-5305 MOORESVILLE 704-664-5281

IMPROVEMENT PERMIT / AUTHORIZATION TO CONSTRUCT / OPERATION PERMIT / EXISTING SYSTEM INSPECTION

PERMIT# REPAIR PIN# 4763-43-1363 DATE 9-4-03

OWNER OR CONTRACTOR TIMOTHY A. FLUKE PHONE: Business Home 704-873-7587

ADDRESS 233 BETHESDA ROAD STATESVILLE NC 28677

LOCATION US 70 EAST, TR BETHESDA ROAD, ON LEFT AT BOX # 233

SUBDIVISION WAYSIDE ESTATES BLOCK / SECTION LOT 3 LOT AREA 100' x 200' SITE CLASS PS DESIGN FLOW 360 L.T.A.R. EXISTING

Septic Tank: EXISTING Gallons; STB Date

Pump Tank: Gallons; PT Date

Pump Make: Model Serial No.

Nitrification Field: No Fields 1 Square Feet EQ. TO 240 Linear Feet 60

No Lines ONE Trench Width 36" Max Trench Bottom Depth 36" Gravel Depth N/A

☐ New System ☑ Repair System Type: I, II, (III), IV, V, VI

System Description:

Repair System Description: 25% REDUCTION, GRAVITY

Maintenance Agreement Required: ☐ Yes ☑ NO

☑ House/Mod. Home No. Bedrooms 3

☐ Mobile Home No. Bathrooms 2

☐ Business No. Employees

☐ Other


☐ Slab ☑ Crawl Space ☐ Basement w/plumbing ☐ Basement wo/plumbing

Water Supply: ☐ Individual ☑ Public ☐ Community


Comments:/Conditions: ① INSTALL NEW 3' x 60' DRAINLINE USING 25% REDUCTION SYSTEM JUST OUTSIDE GAS EASEMENT LINE AS SHOWN ② SYSTEM TO BE REPAIRED PRIOR TO OCCUPANCY OF HOUSE

Comments:/Conditions:

INITIAL SITE SKETCH

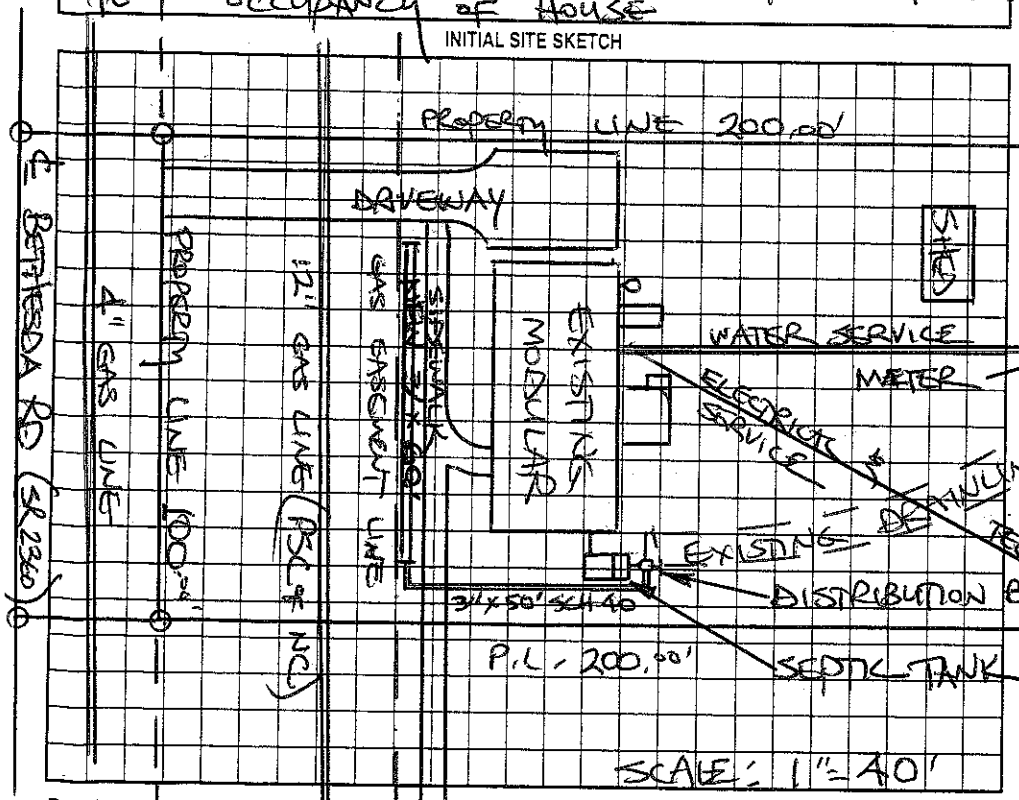

AS BUILT SKETCH

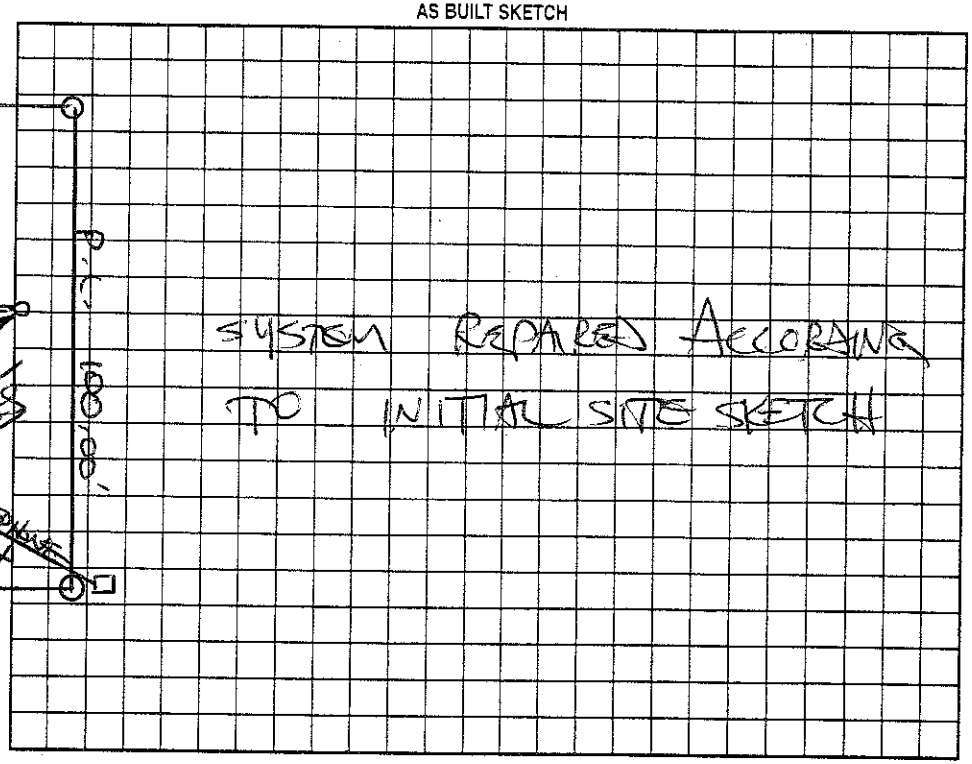

Permit can be suspended or revoked if any false information is supplied toward securing the permit/any unauthorized changes are made to the site/any unauthorized changes are made in the installation of the system. Improvement Permit with plat valid without expiration. Improvement Permit with site plan valid for sixty months. Authorization to Construct is valid for a period equal to that of Improvement Permit – not to exceed sixty months.

Signed: Tim Fluke date 9-4-03 Installed by: ESKER EDGE

Improvement Permit by: STEVE HEDRICK date 9-4-03 Operation Permit by: STEVE HEDRICK date 10-20-03

Authorization to Construct by: STEVE HEDRICK date 9-4-03 Existing System Inspection by: date

HEALTH DEPT. COPY: WHITE OWNER COPY (FINAL): YELLOW OWNER COPY (INITIAL): PINK