IREDELL COUNTY HEALTH DEPARTMENT

Statesville Office (704) 878-5305 Mooresville Office (704) 660-3625 PERMIT # 217126

IMPROVEMENT PERMIT / AUTHORIZATION TO CONSTRUCT / OPERATION PERMIT / EXISTING SYSTEM

PIN # 4763434979

APPLICANT: Freedom Homes APPLICANT ADDRESS: 1124 Charlotte Hwy

SITE ADDRESS: 139 Red Walnut Dr Statesville NC PHONE: 704-881-2326 ALT. PHONE: N/A

SITE DIRECTIONS: 70E T/R Bethesda Rd T/L Red Walnut Rd Lot on left

SUBDIVISION: Wayside Estates SECTION: M1 LOT # 15 LOT AREA: 0.441 ac DESIGN FLOW: 360 L.T.A.R.: Ev

Septic Tank Ev (gal) STB Date

Pump Tank (gal) PT Date

Pump Make Model Serial #

Nitrification Fields Ev # Lines Ev Linear Ft: Ev

Trench Width Ev Max. Trench Bottom Depth Ev Gravel Depth N/A

☐ New System ☐ Repair ☐ Expansion System Type: I II ☒ III IV V VI

System Description: Existing

Repair System Description:

Maintenance Agreement Required: ☐ YES ☒ NO

☒ GRAVITY ☐ PRESSURE

☐ Residence No. Bedrooms 3

☐ Business No. Persons 6

☐ Other No. Employees

☐ Slab ☐ Crawl Space


☐ Basement w/plumbing ☐ Basement w/o plumbing

Water Supply: ☐ Private ☒ Public ☐ Community

Comments / Conditions: All building foundations must be 35' from any part of STS

INITIAL SITE SKETCH

AS BUILT SKETCH

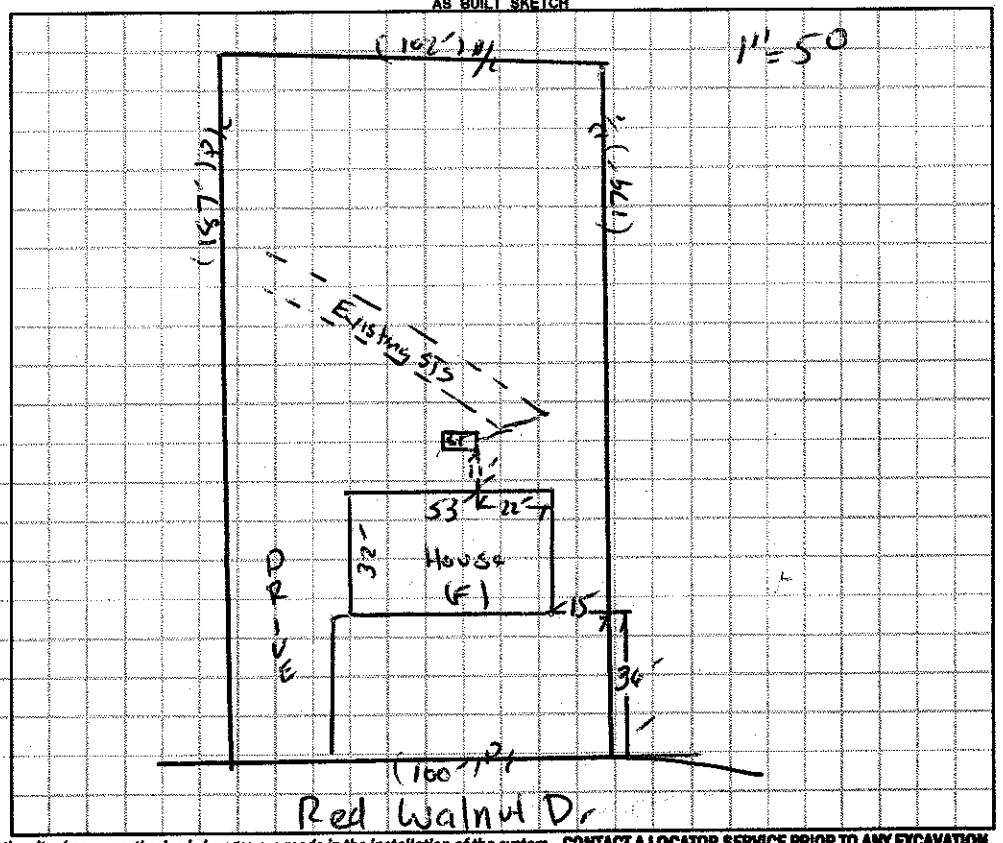

Permit can be suspended or revoked if any false information is supplied toward securing the permit / any unauthorized changes are made to the site / any unauthorized changes are made in the installation of the system. **CONTACT A LOCATOR SERVICE PRIOR TO ANY EXCAVATION**

☐ **IMPROVEMENT PERMIT** *with plat valid without expiration.* ☐ **IMPROVEMENT PERMIT** *with site plan valid for 60 mos.* ☐ **AUTHORIZATION TO CONSTRUCT** *valid for period equal to IMPROVEMENT PERMIT--not to exceed 60 mo.*

Owner / Applicant Signature: Kimberly Sneed Date: 4-7-16 Installed by:

IMPROVEMENT PERMIT by: Date: OPERATION PERMIT by: Date:

AUTHORIZATION TO CONSTRUCT by: Date: Existing System Inspected by: Date: 04/02/16

Health Dept. Copy - WHITE Applicant (Final Approval) - YELLOW Applicant (Conditional Approval) - PINK