IREDELL COUNTY HEALTH DEPARTMENT — STATESVILLE 704-878-5305 — MOORESVILLE 704-664-5281

IMPROVEMENT PERMIT / AUTHORIZATION TO CONSTRUCT / OPERATION PERMIT / EXISTING SYSTEM INSPECTION

PERMIT # 153776 PIN # 4763435074 DATE 12-17-08

OWNER or APPLICANT Bertoldo Toledo / Zoila Benitez PHONE: Business Home: 704-929-2484

OWNER or APPLICANT ADDRESS 116 Bentbrook Statesville NC 28677

LOCATION / DIRECTIONS New 70 East TR Bethesda TL Red Walnut TR Camp Oak TR Bent Brook on RT

SUBDIVISION Wayside BLOCK / SECTION LOT # 56 LOT AREA .55 DESIGN FLOW 360 L.T.A.R. .2

Septic Tank 1000 Gallons: STB 760 Date 9-15-08
Pump Tank Gallons: P T Date
Pump Make Model Serial #
Nitrification Field No Fields No Lines 5 Linear Feet 450
Trench Width 36" Max. Trench Bottom Depth 18" Gravel Depth NA

☑ GRAVITY ☐ PRESSURE

☑ New System ☐ Repair ☐ Expansion System Type II
System Description: 25% Gravity
Repair System Description: 25% Low pres. pump
Maintenance Agreement Required ☐ YES ☐ NO


☑ Residence ☐ Business ☐ Other ☐ Slab ☐ Crawl Space ☐ Basement w/plumbing ☐ Basement w/o plumbing
No. Bedrooms 3 No. Persons No. Employees

Water Supply: ☐ Private ☑ Public ☐ Community

Comments / Conditions

Comments / Conditions
18" trench bottom
Tank At grade or above

INITIAL SITE SKETCH

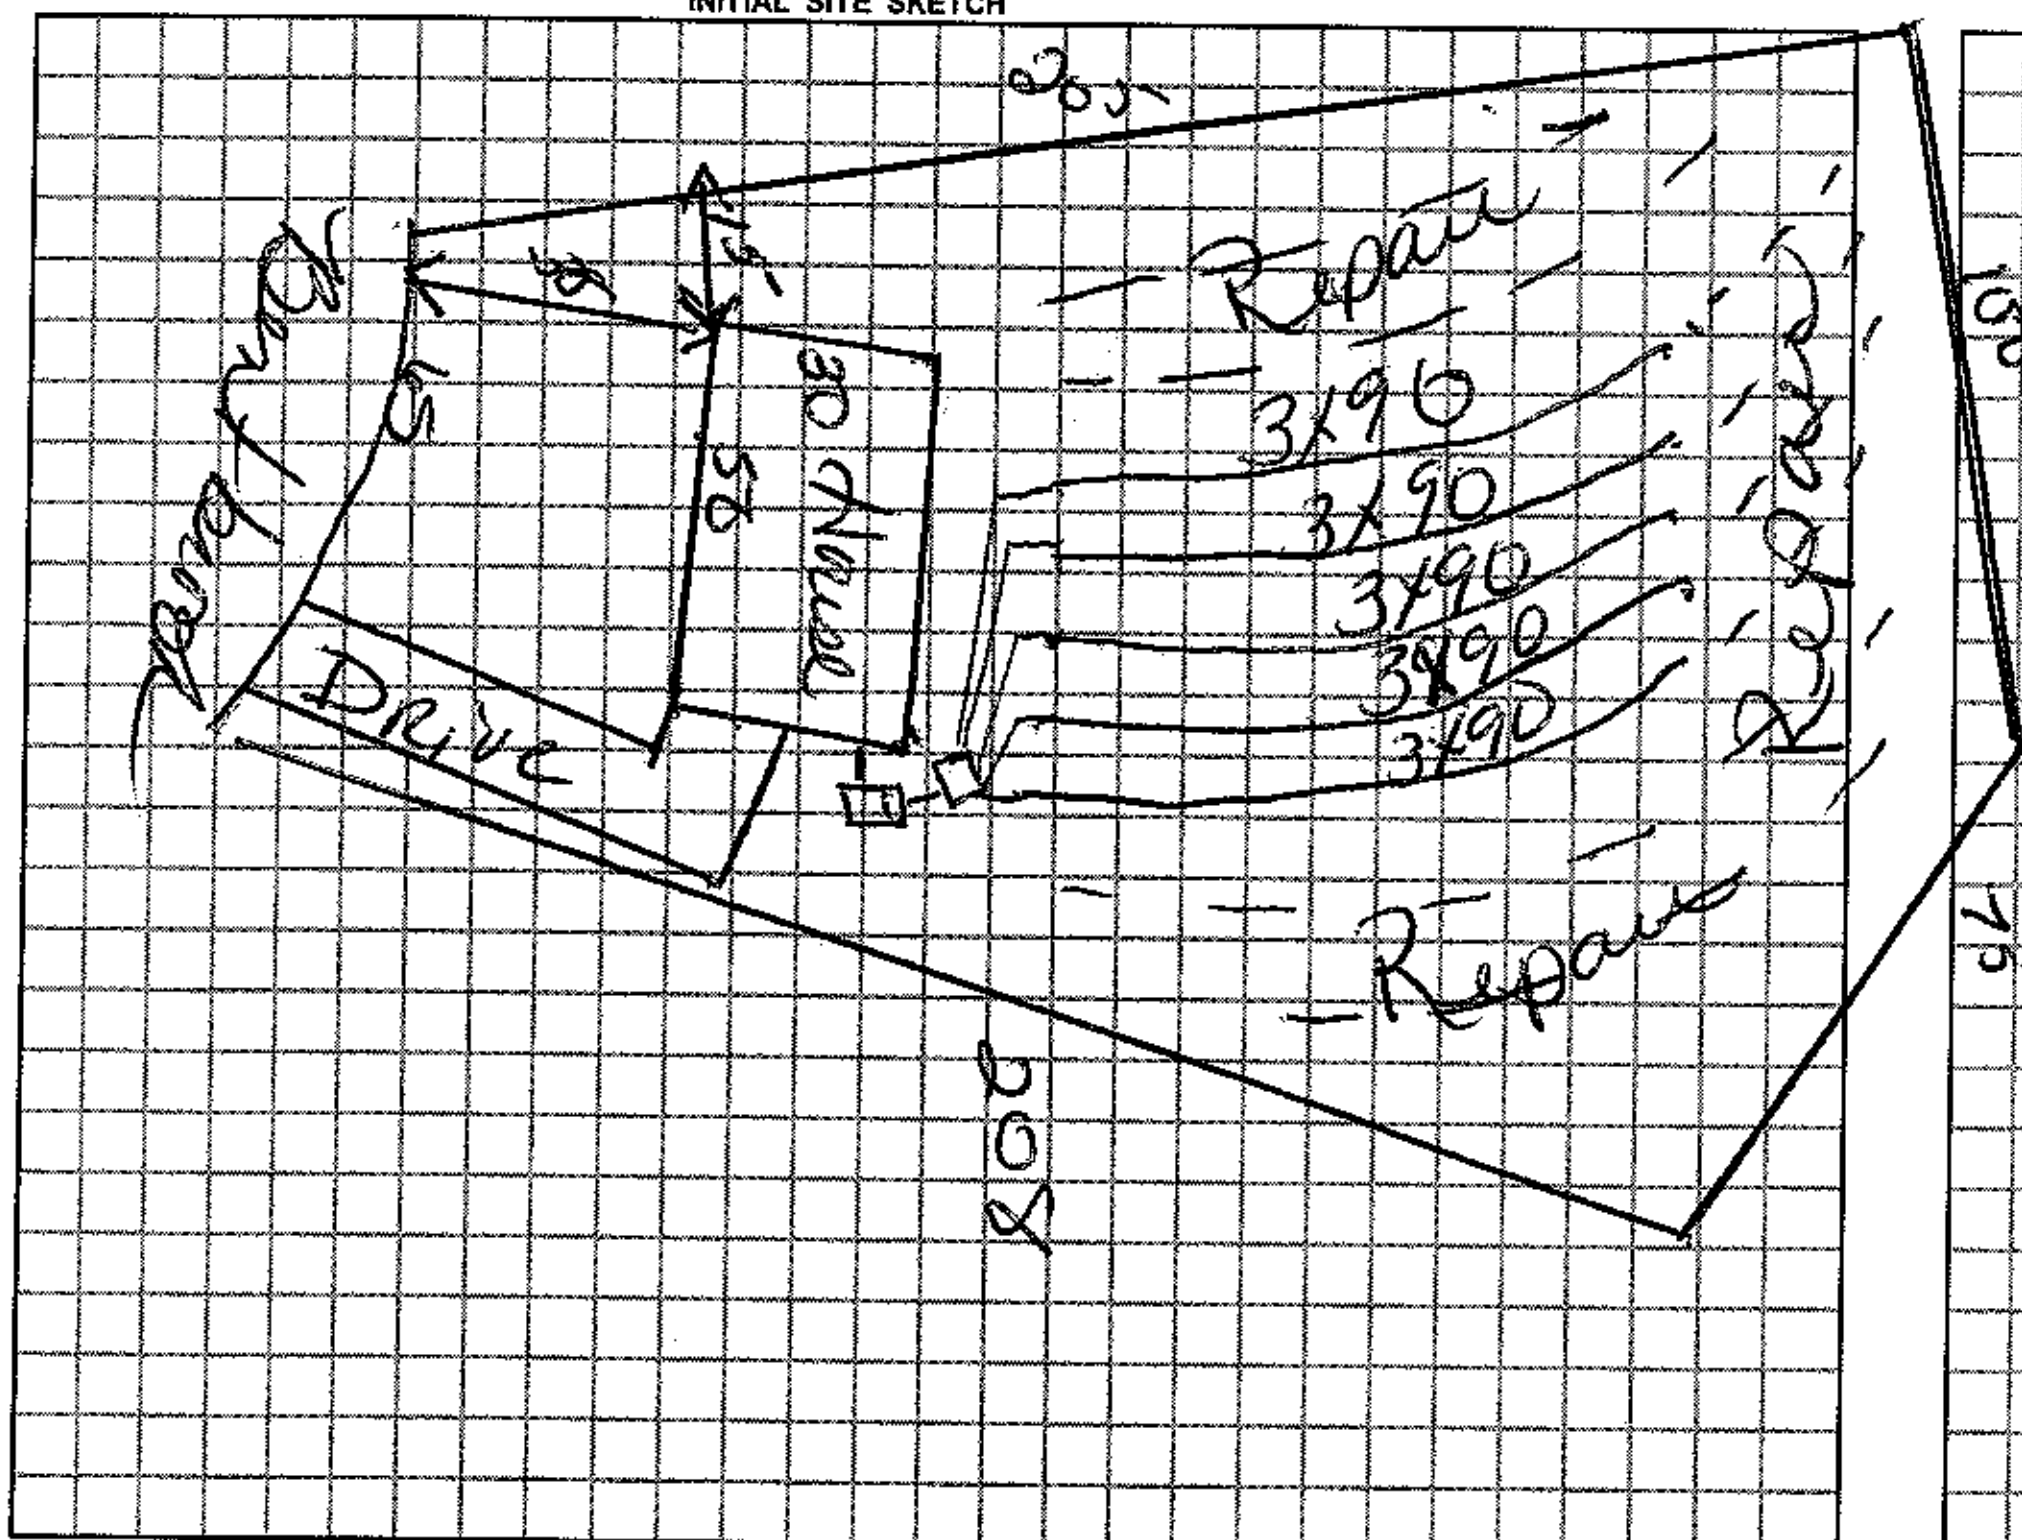

AS BUILT SKETCH

Distribution box with
Speed levels
Red Lif tab

Permit can be suspended or revoked if any false information is supplied toward securing the permit / any unauthorized changes are made to the site / any unauthorized changes are made in the installation of the system.

☐ *IMPROVEMENT PERMIT w / plat valid without expiration.* ☐ *IMPROVEMENT PERMIT w / site plan valid for 60 mos.* ☑ *AUTHORIZATION TO CONSTRUCT valid for period equal to IMPROVEMENT PERMIT-not to exceed 60 mo.*

Owner / Applicant Signature: Bertoldo Benitez T Date 12/17/08
Improvement Permit by: Kevin Cook Date 12-17-08
Authorzation to Construct by: Kevin Cook Date 12-17-08

Installed by: A-1 Backhoe
Operation Permit by: Kevin Cook Date: 1-12-09
Existing System Inspected by: Date:

YOU SHOULD CONTACT A LOCATOR SERVICE PRIOR TO ANY EXCAVATION.

WHITE COPY Environmental Health YELLOW COPY (Final) Owner / Applicant PINK COPY (Initial) Owner / Applicant