IREDELL COUNTY HEALTH DEPARTMENT

STATESVILLE 704-878-5305 MOORESVILLE 704-664-5281

IMPROVEMENT PERMIT / AUTHORIZATION TO CONSTRUCT / OPERATION PERMIT / EXISTING SYSTEM INSPECTION

PERMIT # Repair PIN # 4763 43 5999 DATE 6/30/09

OWNER or APPLICANT Ruperto Santibanez PHONE: Business Home:

OWNER or APPLICANT ADDRESS 143 Red Walnut

LOCATION / DIRECTIONS 70E to (R) on Bethesda, (L) on Red Walnut to 143 on (L)

SUBDIVISION Wayside Estates BLOCK / SECTION LOT # 16 LOT AREA .43 Ac. DESIGN FLOW 240 L.T.A.R.

Septic Tank 1000 Gallons: STB Date

Pump Tank Gallons: P T Date

Pump Make Model Serial #

Nitrification Field No Fields 1 No Lines 1 Linear Feet 75'

Trench Width 36" Max. Trench Bottom Depth 36" Gravel Depth n/a

☐ New System ☒ Repair ☐ Expansion System Type I (II) III IV V VI

System Description: 25% Reduction

Repair System Description:

Maintenance Agreement Required ☐ YES ☒ NO

☒ GRAVITY ☐ PRESSURE

☒ Residence No. Bedrooms 2

☐ Business No. Persons

☐ Other No. Employees

☐ Slab ☒ Crawl Space


☐ Basement w/plumbing ☐ Basement w/o plumbing

Water Supply: ☐ Private ☒ Public ☐ Community


Comments / Conditions

Comments / Conditions

INITIAL SITE SKETCH

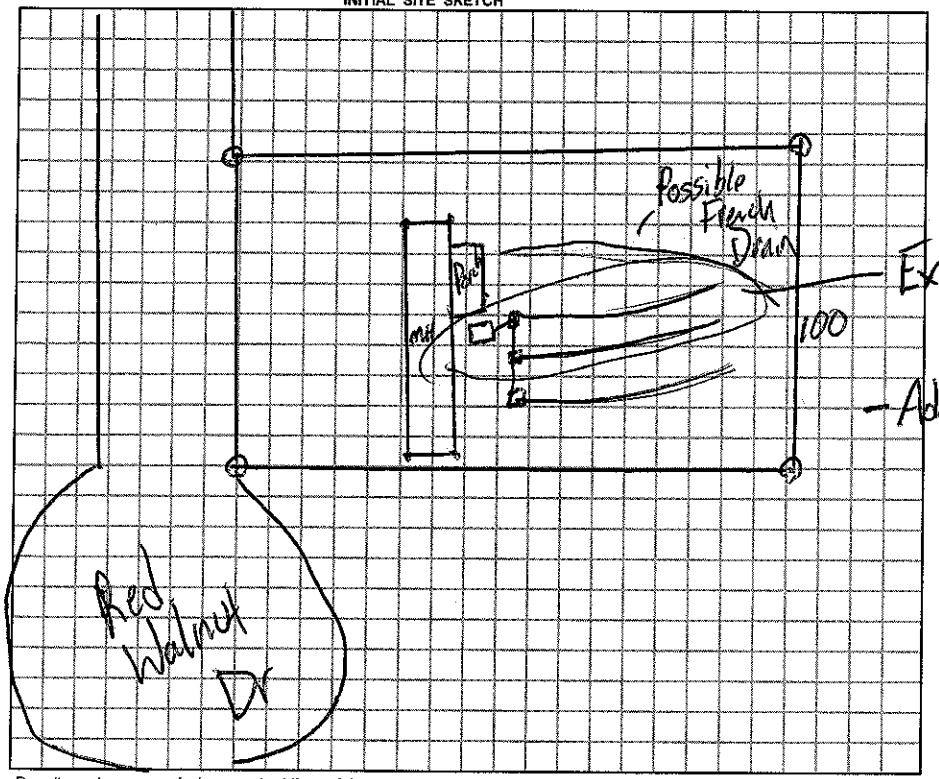

AS BUILT SKETCH

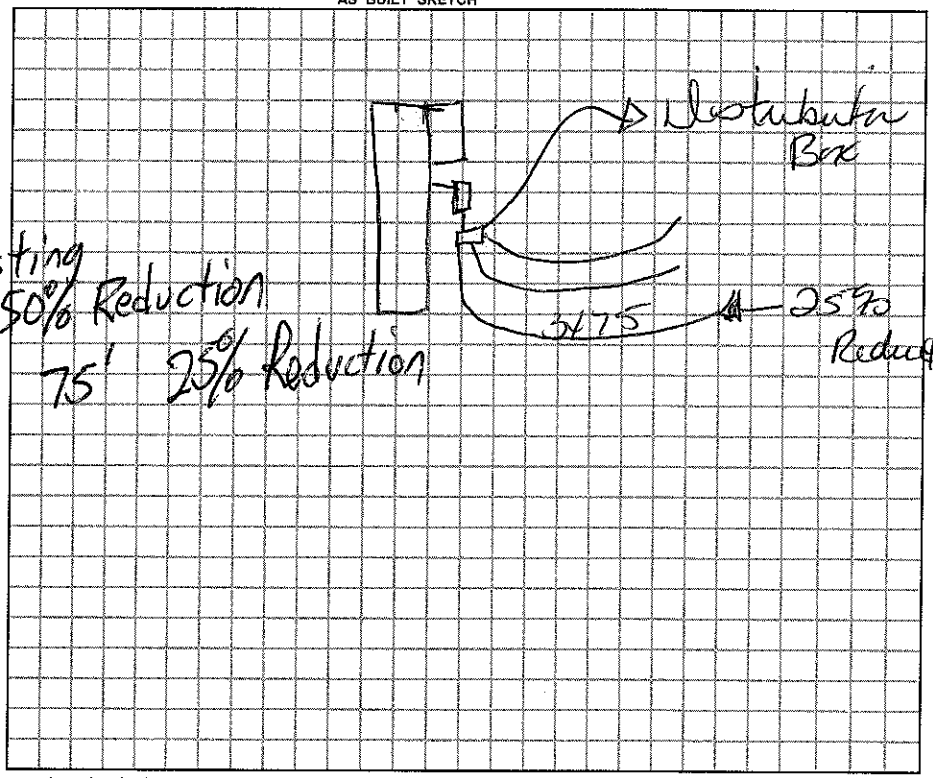

Permit can be suspended or revoked if any false information is supplied toward securing the permit / any unauthorized changes are made to the site / any unauthorized changes are made in the installation of the system.

☐ *IMPROVEMENT PERMIT w / plat valid without expiration.* ☐ *IMPROVEMENT PERMIT w / site plan valid for 60 mos.* ☒ *AUTHORIZATION TO CONSTRUCT valid for period equal to IMPROVEMENT PERMIT-not to exceed 60 mo.*

Owner / Applicant Signature: Dennis Gallien Date 6-30-09

Improvement Permit by: Date

Authorization to Construct by: Date 6-30-09

Installed by: A-1 Backhoe

Operation Permit by: Date: 7-6-09

Existing System Inspected by: Date:

YOU SHOULD CONTACT A LOCATOR SERVICE PRIOR TO ANY EXCAVATION.

WHITE COPY Environmental Health YELLOW COPY (Final) Owner / Applicant PINK COPY (Initial) Owner / Applicant