DELL COUNTY HEALTH DEPARTMENT

STATESVILLE 704-878-5305 (01) MOORESVILLE 704-664-5281

IMPROVEMENT PERMIT / AUTHORIZATION TO CONSTRUCT / OPERATION PERMIT / EXISTING SYSTEM INSPECTION

PERMIT# 111994 PIN# 4763-44-6082 DATE 5-29-03

OWNER OR CONTRACTOR RUPERTO & SOCURRO SANTIBANEZ PHONE: Business 704-252-2035 Home 704-871-0172

ADDRESS 147 RED WALNUT DRIVE, STATESVILLE NC 28677

LOCATION US70 EAST TR BETHESDA ROAD, TL RED WALNUT DRIVE, LOT AT END ON LEFT

SUBDIVISION WAYSIDE ESTATES BLOCK / SECTION ____ LOT 17 LOT AREA LIMITED SITE CLASS. PS DESIGN FLOW 360 L.T.A.R. 0.30 GPD/FT²

Septic Tank: 1000 Gallons; STB 1012 Date 12-2-02
Pump Tank: ____ Gallons; PT ____ Date ____
Pump Make: ____ Model ____ Serial No. ____
Nitrification Field: No Fields 1 Square Feet EQ TO 1200 Linear Feet 200
No Lines FOUR Trench Width 24" Max Trench Bottom Depth 36"

☑ New System ☐ Repair System Type: I, II, III, IV, V, VI
System Description: 50% REDUCTION, GRAVITY
Repair System Description: 50% REDUCTION, LOW PRESSURE
Maintenance Agreement Required: ☐ Yes ☑ No
Gravel Depth SAND 24" ☐ Slab ☑ Crawl Space ☐ Basement w/plumbing ☐ Basement wo/plumbing


☐ House/Mod. Home No. Bedrooms 3
☑ Mobile Home No. Bathrooms 2
☐ Business No. Employees ____
☐ Other ____

Water Supply: ☐ Individual ☑ Public ☐ Community

Comments/Conditions: ① GRADE SITE TO PROVIDE POSITIVE DRAINAGE DITCH AT LOCATION SHOWN, PROVIDE UNIFORM SLOPE OVER DRAINFIELD WITH NO FILL DIRT. ② USE 48 PPBPS PANELS AS SHOWN ON CONTOUR.

Comments/Conditions: SEPTIC TANK INSTALLED WITH MARKER USING "TUFFITE" FILTER

INITIAL SITE SKETCH

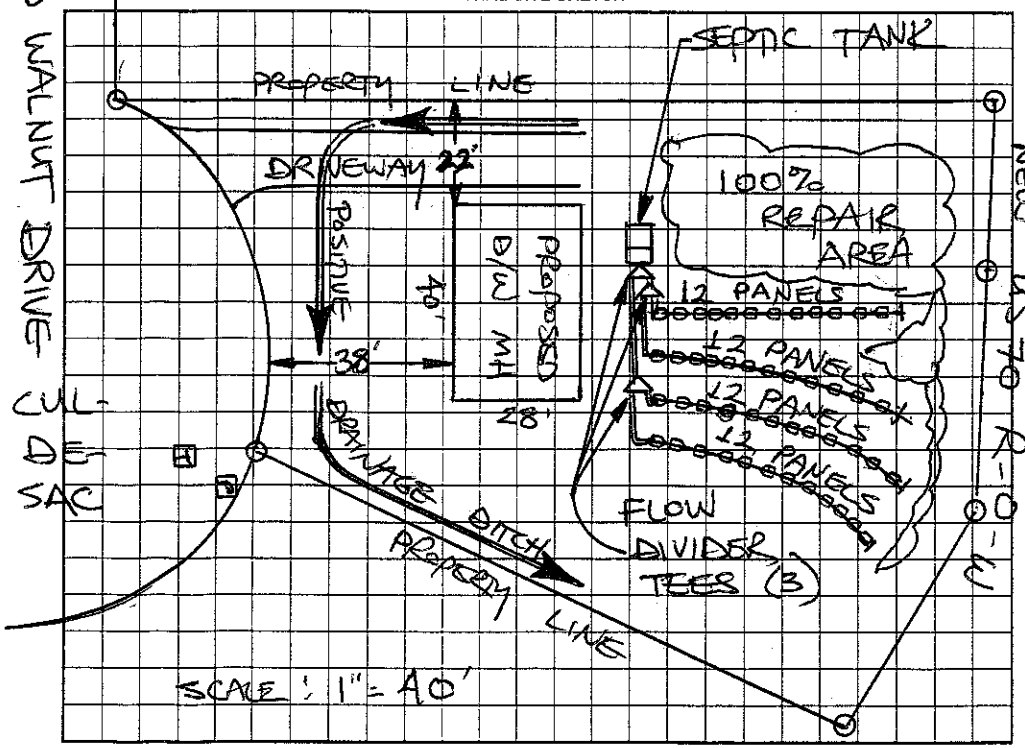

AS BUILT SKETCH

SYSTEM INSTALLED ACCORDING TO INITAL SITE SKETCH

Permit can be suspended or revoked if any false information is supplied toward securing the permit/any unauthorized changes are made to the site/any unauthorized changes are made in the installation of the system. Improvement Permit with plat valid without expiration. Improvement Permit with site plan valid for sixty months. Authorization to Construct is valid for a period equal to that of Improvement Permit – not to exceed sixty months.

Signed: Jennas Dallas date 5-30-03 Installed by: A-1 BACKHOE

Improvement Permit by: STEVE HEDRICK date 5-29-03 Operation Permit by: STEVE HEDRICK date 6-3-03

Authorization to Construct by: STEVE HEDRICK date 5-29-03 Existing System Inspection by: ____ date ____

HEALTH DEPT. COPY: WHITE OWNER COPY (FINAL): YELLOW OWNER COPY (INITIAL): PINK