IREDELL COUNTY HEALTH DEPARTMENT

STATESVILLE 704-878-5305 MOORESVILLE 704-664-5281

IMPROVEMENT PERMIT / AUTHORIZATION TO CONSTRUCT / OPERATION PERMIT / EXISTING SYSTEM INSPECTION

PERMIT# Repair PIN# 4763-48-8299 DATE 2/4/02

OWNER OR CONTRACTOR Bill Shoemaker PHONE: Business — Home (704) 872-7015

ADDRESS 900 Bell Farm Rd Statesville N.C. 28625

LOCATION Hwy 70 E, @ Bell Farm Rd, 1st White House on Left

SUBDIVISION — BLOCK / SECTION — LOT — LOT AREA 4.8 Ac. SITE CLASS. P8 DESIGN FLOW 360 L.T.A.R. Existing

Septic Tank: Existing 1000 Gallons; STB — Date —

Pump Tank: — Gallons; PT — Date —

Pump Make: — Model — Serial No. —

Nitrification Field: No Fields 1 Square Feet 900 Linear Feet 300

No Lines 3 @ 100' Trench Width 36" Max Trench Bottom Depth 36" Gravel Depth 12"

☐ New System ☒ Repair System Type: I (II) III, IV, V, VI

System Description: —

Repair System Description: Gravity, Conventional

Maintenance Agreement Required: ☐ Yes ☐ No

☒ House/Mod. Home No. Bedrooms 3

☐ Mobile Home No. Bathrooms 1

☐ Business No. Employees —

☐ Other —


☐ Slab ☒ Crawl Space ☐ Basement w/plumbing ☐ Basement wo/plumbing

Water Supply: ☒ Individual ☐ Public ☐ Community


Comments:/Conditions: ① Add 3 three 100ft Lines on Contour ② Add New distribution box if necessary ③ Reroute washer drain into septic tank

Comments:/Conditions: — Installed New distribution box

INITIAL SITE SKETCH

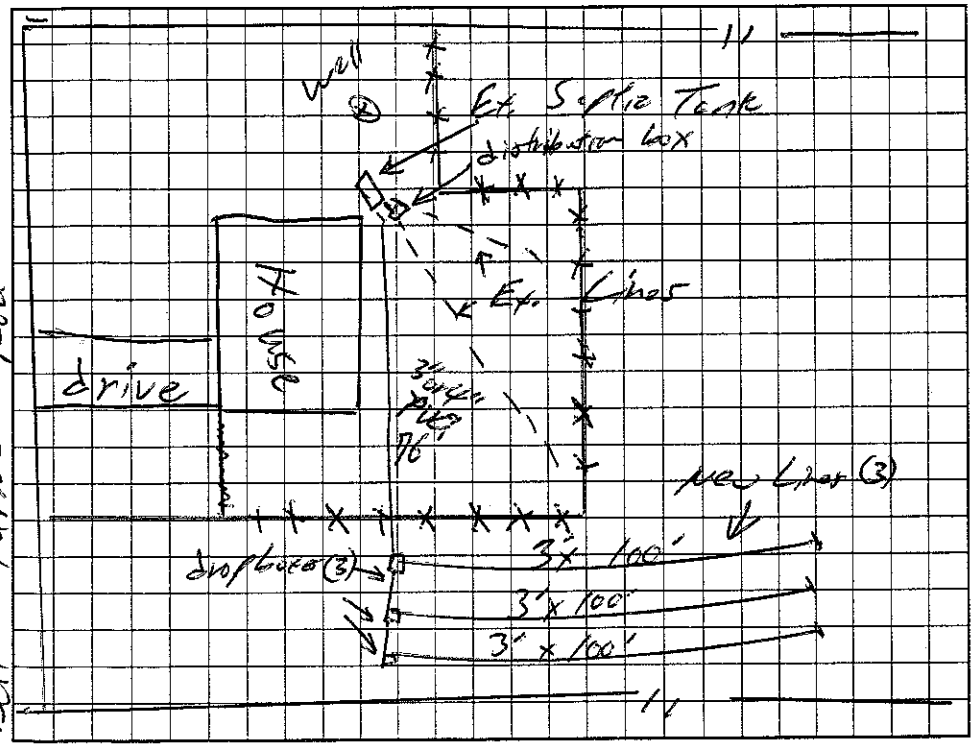

AS BUILT SKETCH

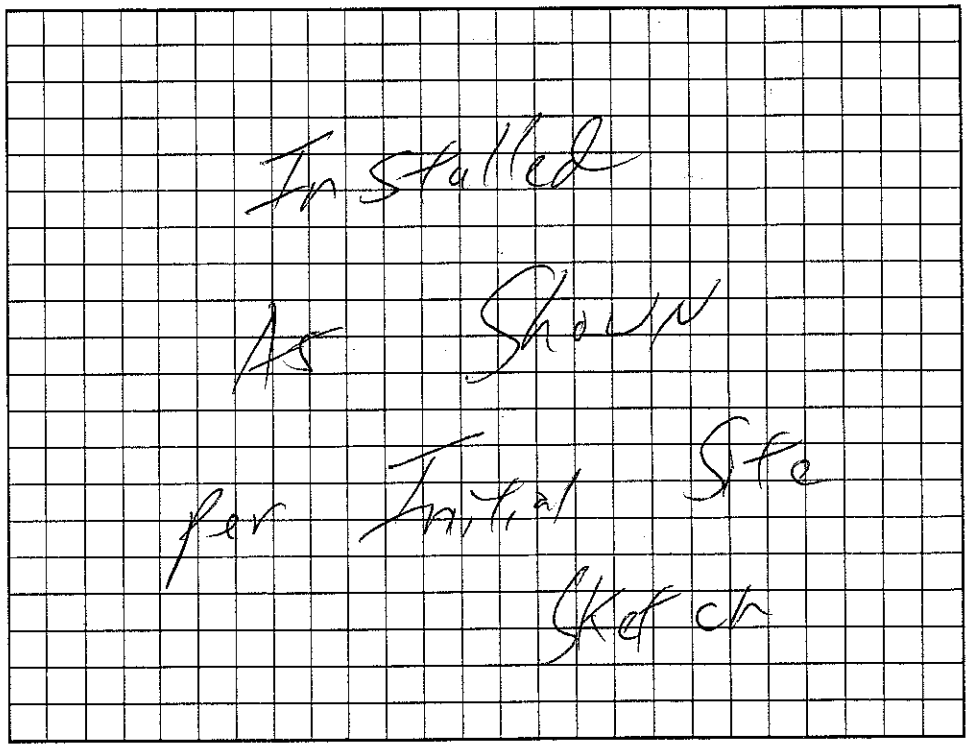

Permit can be suspended or revoked if any false information is supplied toward securing the permit/any unauthorized changes are made to the site/any unauthorized changes are made in the installation of the system. Improvement Permit with plat valid without expiration. Improvement Permit with site plan valid for sixty months. Authorization to Construct is valid for a period equal to that of Improvement Permit – not to exceed sixty months.

Signed: Bobbie L Shoemaker date 2/4/02 Installed by: James Husker

Improvement Permit by: William O. Johnson date 2/4/02 Operation Permit by: William O. Johnson date 3/25/03

Authorization to Construct by: William O. Johnson date 2/4/02 Existing System Inspection by: — date —

HEALTH DEPT. COPY: WHITE OWNER COPY (FINAL): YELLOW OWNER COPY (INITIAL): PINK