IREDELL COUNTY HEALTH DEPARTMENT

STATESVILLE 704-878-5305 MOORESVILLE 704-664-5281

IMPROVEMENT PERMIT / AUTHORIZATION TO CONSTRUCT / OPERATION PERMIT / EXISTING SYSTEM INSPECTION

PERMIT# 139452 PIN# 4776351960 DATE 12-29-06

OWNER OR APPLICANT Peggy Benfield PHONE: Business 704-872-0179 Home

ADDRESS 126 Treeline Drive, Statesville 28625

LOCATION 70E TR Bethesda (R) Tree Line Lot on Right

SUBDIVISION Forest Hill BLOCK / SECTION LOT 160 LOT AREA 15800 SITE CLASS. RS DESIGN FLOW 360 L.T.A.R. .3

Septic Tank: 1000 Gallons; STB Date

Pump Tank: Gallons; PT Date

Pump Make: Model Serial No.

Nitrification Field: No Fields 2 Square Feet 1200 Linear Feet 300

No Lines 4 Trench Width 36" Max Trench Bottom Depth 36"

☑ New System ☐ Repair ☐ Expansion System Type: I II (III) IV V VI

System Description: Expansion 25% Reserve

Repair System Description: New Pump Panel

Maintenance Agreement Required: ☐ Yes ☐ No

Gravel Depth ☑ Gravity ☐ Pressure

☐ House/Mod. Home ☐ Mobile Home ☐ Business ☐ Other

No. Bedrooms 3 No. Persons No. Employees

Water Supply: ☐ Individual ☐ Public ☐ Community

☐ Slab ☐ Crawl Space ☐ Basement w/plumbing ☐ Basement wo/plumbing


Comments:/Conditions:

* Feed lines end cap to end cap
* use Bell Run Valve - Feed New System 100% -

Comments:/Conditions:

Maintain all setbacks

INITIAL SITE SKETCH

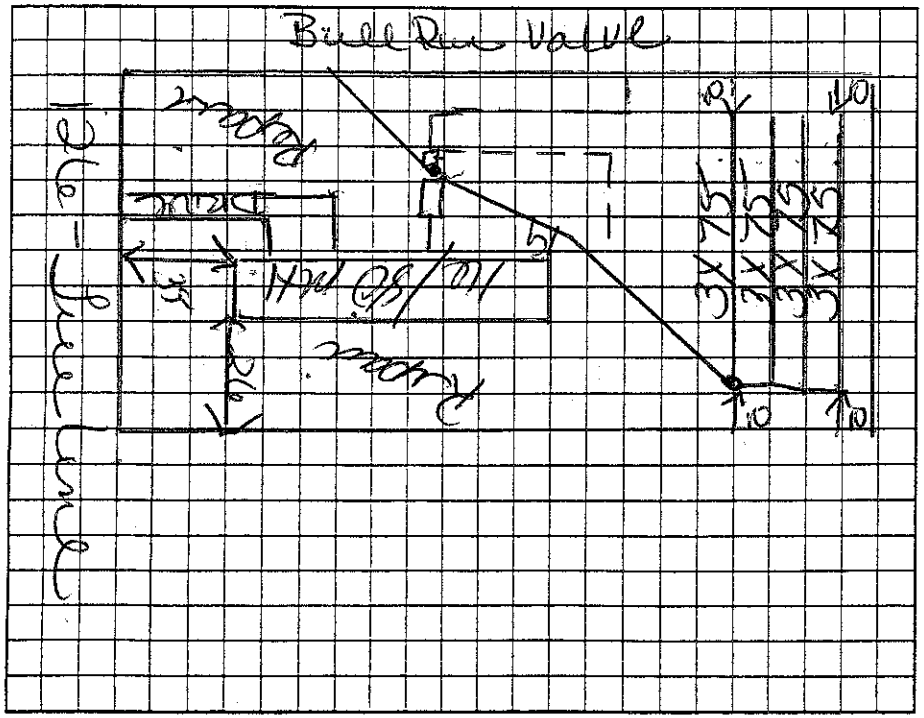

AS BUILT SKETCH

Installed T for divider & the existing two lines - Installed Bell Run valve

Permit can be suspended or revoked if any false information is supplied toward securing the permit/any unauthorized changes are made to the site/any unauthorized changes are made in the installation of the system. Improvement Permit with plat valid without expiration ☐ Improvement Permit with site plan valid for sixty months ☐ Authorization to Construct is valid for a period equal to that of Improvement Permit – not to exceed sixty months.

Signed: date 1-5-07 Installed by: A-1 Backhoe

Improvement Permit by: Kelly Cox date 12-29-06 Operation Permit by: Kelly Cox date 1-24-07

Authorization to Construct by: Kelly Cox date 12-29-06 Existing System Inspection by: date

HEALTH DEPT. COPY: WHITE OWNER COPY (FINAL): YELLOW OWNER COPY (INITIAL): PINK