IREDELL COUNTY HEALTH DEPARTMENT

STATESVILLE 704-878-5305 MOORESVILLE 704-664-5281

IMPROVEMENT PERMIT / AUTHORIZATION TO CONSTRUCT / OPERATION PERMIT / EXISTING SYSTEM INSPECTION

PERMIT# REPAIR PIN# (Lot 50) 4763-52-1983 // 4763-52-2972 (Lot 49) DATE 6-20-08

OWNER OR APPLICANT RUPERTO SANTIBANEZ PHONE: Business _____ Home _____

ADDRESS 140 BENTBROOK ROAD STATESVILLE NC 28677

LOCATION BETHESDA ROAD TO RED WALNUT DR, TR CAMP OAK RD, TR BENTBROOK RD, 10TH LOT ON RIGHT

SUBDIVISION WAYSIDE EST. BLOCK / SECTION _____ LOT 49/50 LOT AREA 200' X 180' SITE CLASS. PS DESIGN FLOW 360 L.T.A.R. 0.25GPD/FT²

Septic Tank: EXISTING Gallons: STB _____ Date _____

Pump Tank: _____ Gallons: PT _____ Date _____

Pump Make: _____ Model EQUIV Serial No. _____

Nitrification Field: No Fields 1 Square Feet 736 Linear Feet 184'

No Lines THREE Trench Width 36" Max Trench Bottom Depth 36" Gravel Depth N/A

☐ New System ☑ Repair ☐ Expansion System Type: I II (III) IV V VI

System Description: _____

Repair System Description: 25% REDUCTION

Maintenance Agreement Required: ☐ Yes ☑ No

☐ House/Mod. Home ☑ Mobile Home ☐ Business ☑ Other

No. Bedrooms 3 No. Persons ____ No. Employees ____

Water Supply: ☐ Individual ☑ Public ☐ Community


☑ Gravity ☐ Pressure ☐ Slab ☑ Crawl Space ☐ Basement w/plumbing ☐ Basement wo/plumbing

Comments:/Conditions:


① INSTALL NEW 25% REDUCTION SYSTEM ON CONTOUR AS SHOWN USING SERIAL DISTRIBUTION

② SYSTEM TO BE REPAIRED BY JULY 10, 2008

INITIAL SITE SKETCH ~ SCALE: 1"=40' (THIS IS NOT A SURVEY)

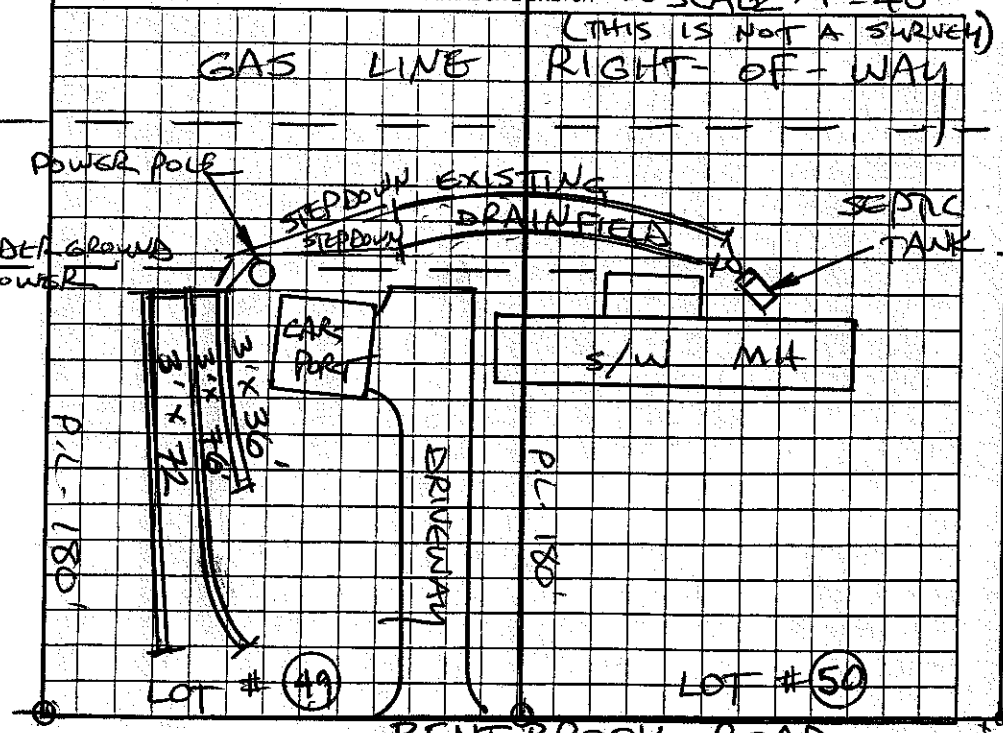

AS BUILT SKETCH

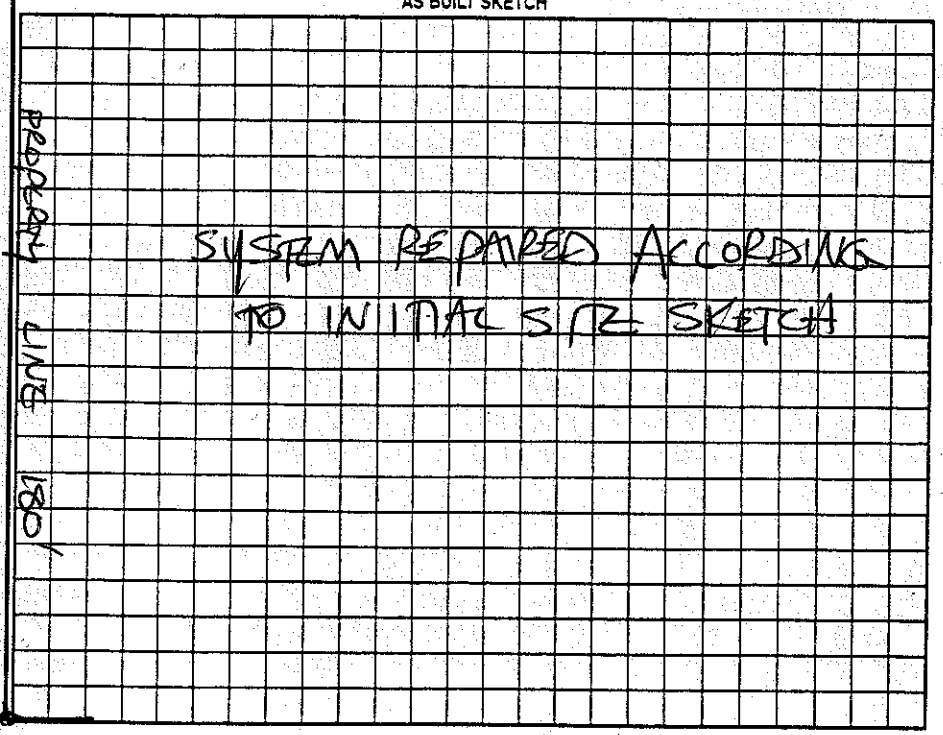

Permit can be suspended or revoked if any false information is supplied toward securing the permit/any unauthorized changes are made to the site/any unauthorized changes are made in the installation of the system. Improvement Permit with plat valid without expiration ☐ Improvement Permit with site plan valid for sixty months ☑ Authorization to Construct is valid for a period equal to that of Improvement Permit – not to exceed sixty months.

Signed: Genaro Santibanez date 6-20-08 Installed by: TUCKERS HAULING & GRADING

Improvement Permit by: STEVE HEDRICK date 6-20-08 Operation Permit by: STEVE HEDRICK date 6-25-08

Authorization to Construct by: STEVE HEDRICK date 6-20-08 Existing System Inspection by: _____ date _____

HEALTH DEPT. COPY: WHITE OWNER COPY (FINAL): YELLOW OWNER COPY (INITIAL): PINK