IREDELL COUNTY HEALTH DEPARTMENT

STATESVILLE 704-878-5305 MOORESVILLE 704-664-5281

IMPROVEMENT PERMIT / AUTHORIZATION TO CONSTRUCT / OPERATION PERMIT / EXISTING SYSTEM INSPECTION

DATE 6/21/02

PERMIT# 106637 PIN# 4763 52 4296

OWNER OR CONTRACTOR Leonard Lafuzia PHONE Business Home 704-871-1076

ADDRESS 121 Sylvan Dr. Statesville, NC 28677

LOCATION 21-115 South to Do Amby Tr Bethesda 2.5 mile

SUBDIVISION Forest Acres BLOCK / SECTION LOT 107 LOT AREA EXISTING SITE CLASS DESIGN FLOW 240 L.T.A.R.

Septic Tank: EXISTING Gallons: STB Date

Pump Tank: Gallons: PT Date

Pump Make: Model Serial No

Nitrification Field: No Fields EXISTING SYSTEM

No Lines BED Trench Width Max Trench Bottom Depth

☐ New System ☐ Repair System Type: I II III IV V VI

System Description: EXISTING SYSTEM

Repair System Description:

Maintenance Agreement Required: ☐ Yes ☐ No

Gravel Depth

☒ House/Mod. Home No. Bedrooms 2

☐ Mobile Home No. Bathrooms 2

☐ Business No. Employees

☐ Other

☐ Slab ☒ Crawl Space ☐ Basement w/plumbing ☐ Basement w/o plumbing

Water Supply: ☐ Individual ☒ Public ☐ Community


Comments/Conditions:

Comments/Conditions:

*Approved for 3 Bedroom Home Only.!!

INITIAL SITE SKETCH

AS BUILT SKETCH

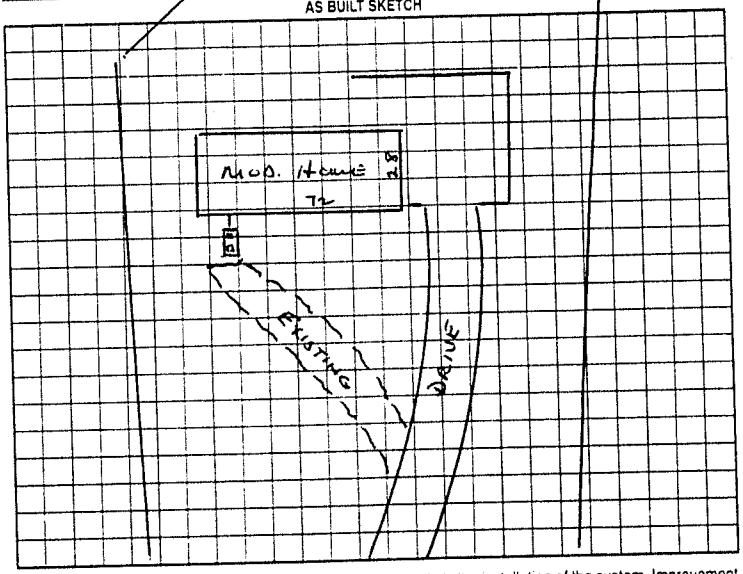

Permit can be suspended or revoked if any false information is supplied toward securing the permit/any unauthorized changes are made to the site/any unauthorized changes are made in the installation of the system. Improvement Permit with plat valid without expiration. Improvement Permit with site plan valid for sixty months. Authorization to Construct is valid for a period equal to that of Improvement Permit – not to exceed sixty months

Signed: Larry W. Mosely date 6-26-02

Improvement Permit by: date

Authorization to Construct by: date

Installed by:

Operation Permit by: date

Existing System Inspection by: Wesley Sparks RS. date 6/21/02

HEALTH DEPT. COPY WHITE OWNER COPY (FINAL) YELLOW OWNER COPY (INITIAL) PINK