TERESA ANN HEDDEN

IREDELL COUNTY HEALTH DEPARTMENT

STATESVILLE 704-878-5305 MOORESVILLE 704-664-5281

IMPROVEMENT PERMIT / CERTIFICATE OF COMPLETION / OPERATION PERMIT / EXISTING SYSTEM INSPECTION

3856

PROPERTY DESCRIPTION NO. 2112 DATE 7-21-95 TAX MAP NO. 5K-4- 4-38 Watershed: ☐ Yes ☐ No

OWNER OR CONTRACTOR T+T PHONE: Business 8[illegible]6660 Home [illegible]

ADDRESS PO Box 288 Statesville N.C. (36) 4763-53-6115 (11) 4763-52-5902 (48) 4763-52-3982

LOCATION 70E TR Bethesda Th Bentbrook 3rd lot from entron left

SUBDIVISION Wayside BLOCK / SECTION 2 LOTS LOT AREA 1.55acres SITE CLASS. PS DESIGN FLOW 360 L.T.A.R. .28

Septic Tank: 1000 Gallons; STB 1012 Date 4-27-95 ~~4-27-95~~

Pump Tank: 1000 Gallons; PT ~~1012~~ 17 Date 1-20-95

Pump Make: Littlegiant Model 1½E Serial No. 514526

Nitrification Field: No Fields 1 Square Feet 1044 Linear Feet 348

No Lines 5 Trench Width 36" Max Trench Bottom Depth 24" Gravel Depth N/A

☐ New System ☐ Repair System Type: I, II, III, IV, V, VI

System Description: Pressure dosed chambered system

Repair System Description: APP

Maintenance Agreement Required: ☑ Yes ☐ No

☐ House/Mod. Home No. Bedrooms 3

☐ Mobile Home No. Bathrooms 2

☐ Business No. Employees ____

☐ Other ____


☐ Slab ☑ Crawl Space ☐ Basement w/plumbing ☐ Basement wo/plumbing

Water Supply: ☐ Individual ☐ Community ☑ Public

1HP

Comments: See Attached sheets for Pump tank + wiring requirements Also see sht for Drain line const. standard which will be part of this Permit. An Easement must be obtained from Dept of Transportation to Run said sewage line under state Road

INITIAL SITE SKETCH

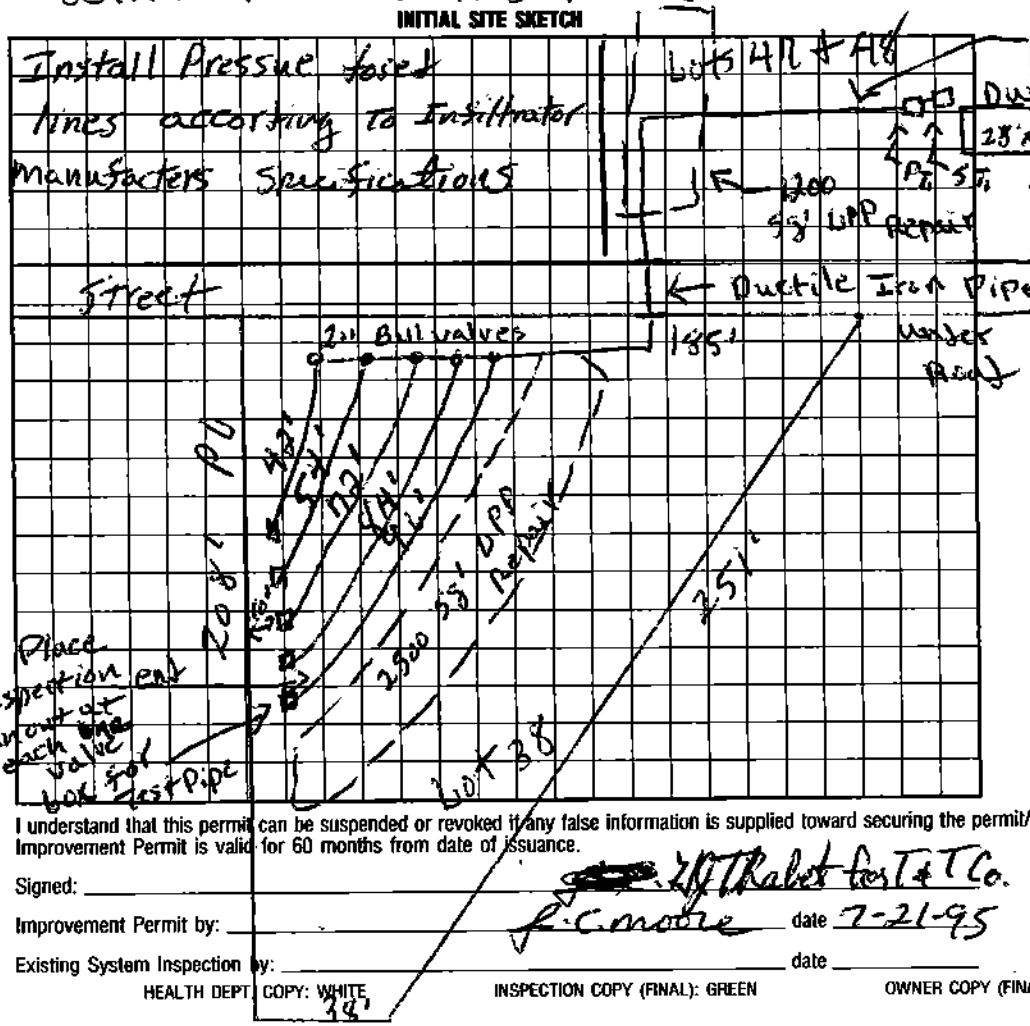

AS BUILT SKETCH

Lines Checked 11-1-95

Pump + Valves Ck 11-27

Alarm + Breather 12-1-95

Before System can be Issued operations Permit a contract with a certified operator must be made + Copy kept with Health Dept. Also an Easement to Run Sewage on Road R/W must be on file with the

I understand that this permit can be suspended or revoked if any false information is supplied toward securing the permit/any unauthorized changes are made to the site/any unauthorized changes are made in the installation of the syste

Improvement Permit is valid for 60 months from date of issuance.

Signed: [illegible] T+T Rabbit for T+T Co.

Improvement Permit by: P.C. Moore date 7-21-95

Existing System Inspection by: ____ date ____

Installed by: Tommy Frye 12-1-1995 date

Certificate of Completion by: [illegible] date

Operation Permit by: P.C. moore date 12-1-9

HEALTH DEPT COPY: WHITE INSPECTION COPY (FINAL): GREEN OWNER COPY (FINAL): YELLOW INSPECTION COPY (INITIAL): PINK OWNER COPY (INITIAL): GOLD