IREDELL COUNTY HEALTH DEPARTMENT

STATESVILLE 704-878-5305 MOORESVILLE 704-664-5281

IMPROVEMENT PERMIT / AUTHORIZATION TO CONSTRUCT / OPERATION PERMIT / EXISTING SYSTEM INSPECTION

PERMIT# Repair / 07346 PIN# 4763527098

OWNER OR CONTRACTOR Brenda Bloom DATE 5-18-98

ADDRESS 236 Pearl St. Salisbury PHONE: Business Home 633-4146

LOCATION 70E TR Bethesda TL Treeline TL Sylvan Lot on (R) just befor cul de sac.

SUBDIVISION Forest Acres BLOCK / SECTION 1 LOT 111 LOT AREA SITE CLASS DESIGN FLOW L.T.A.R. 0.4 Existing

Septic Tank: 1000 Existing Gallons; STB Date

Pump Tank: Gallons; PT Date

Pump Make: Model Serial No.

Nitrification Field: No Fields Square Feet Linear Feet 100

No Lines 2 Trench Width 24in Max Trench Bottom Depth 36in ~~Gravel Depth~~ Sand

☐ New System ☒ Repair System Type: I, II, (III), IV, V, VI

System Description:

Repair System Description: Gravity Panel

Maintenance Agreement Required: ☐ Yes ☐ No

☐ House/Mod. Home ☒ Mobile Home ☐ Business ☐ Other

No. Bedrooms 3 No. Bathrooms 2 No. Employees


Water Supply: ☐ Individual ☒ Public ☐ Community

☐ Slab ☐ Crawl Space ☐ Basement w/plumbing ☐ Basement wo/plumbing


Comments:/Conditions: Install 2 lines 50ft Panels keep lines on contour, Install bull run valve to shut off existing lines. use Dist Box to feed New lines w/speed levelers.

Comments:/Conditions: Existing System Check - Needed Repair

INITIAL SITE SKETCH

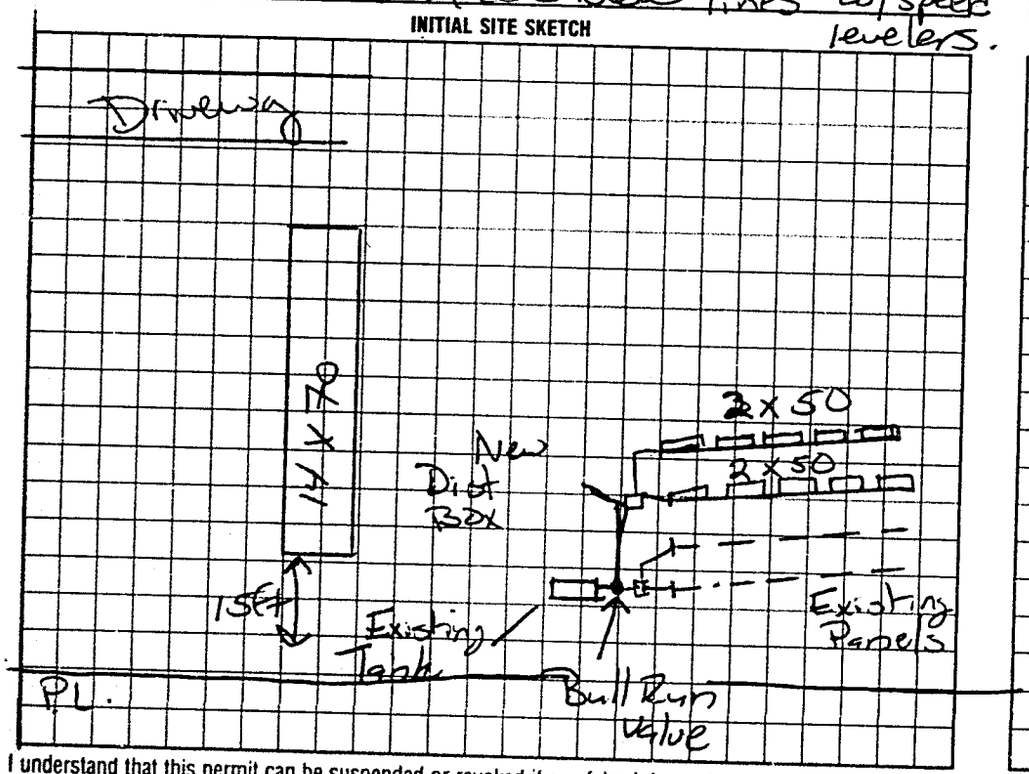

AS BUILT SKETCH

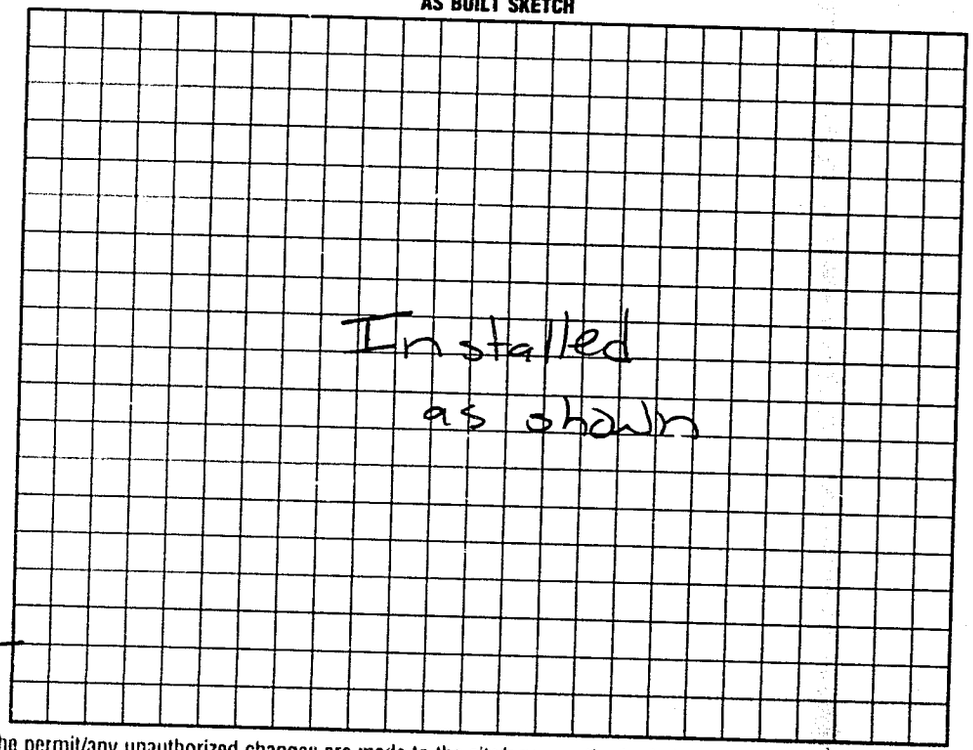

I understand that this permit can be suspended or revoked if any false information is supplied toward securing the permit/any unauthorized changes are made to the site/any unauthorized changes are made in the installation of the system. Improvement Permit with plat valid without expiration. Improvement Permit with site plan valid for sixty months. Authorization to Construct is valid for a period equal to that of Improvement Permit – not to exceed ~~sixty~~ months.

Signed: Brenda W. Bloom date 5-20-98

Improvement Permit by: Mary Coutts date 5-18-98

Authorization to Construct by: Mary Coutts date 5-18-98

Installed by: Berry Simmon

Operation Permit by: Mary Coutts date 7-9-98

Existing System Inspection by: date

HEALTH DEPT. COPY: WHITE INSPECTION COPY (FINAL): GREEN OWNER COPY (FINAL): YELLOW INSPECTION COPY (INITIAL): PINK OWNER COPY (INITIAL): GOLD