12:00

IREDELL COUNTY HEALTH DEPARTMENT

STATESVILLE 704-878-5305 MOORESVILLE 704-664-5281

IMPROVEMENT PERMIT / CERTIFICATE OF COMPLETION / OPERATION PERMIT / EXISTING SYSTEM INSPECTION

PROPERTY DESCRIPTION NO. 26019 DATE 2-27-97 TAX MAP NO. Pin 4763-57-3335 Watershed: ☐ Yes ☒ No

OWNER OR CONTRACTOR T+T Inc PHONE: Business Home

ADDRESS 849 Bell Fm Rd Statesville

LOCATION 64E TR Bell Fm Rd TL oakcreek TR Buckwheat 9th lot left

SUBDIVISION Oak Creek BLOCK / SECTION LOT 349 LOT AREA 14558 SITE CLASS PS DESIGN FLOW 360 L.T.A.R. 1.3

Septic Tank: 1000 Gallons; STB 160 GW Date 5/30/00
Pump Tank: Gallons; PT Date
Pump Make: Model Serial No.
Nitrification Field: No Fields 1 Square Feet 900 Linear Feet 300
No Lines 4 Trench Width 36" Max Trench Bottom Depth 36" Gravel Depth N/A

☒ New System ☐ Repair System Type: I, II, III, IV, V, VI
System Description: Gravity/Chambers
Repair System Description: Prus Block Panel
Maintenance Agreement Required: ☐ Yes ☒ No

☐ House/Mod. Home ☒ Mobile Home ☐ Business ☐ Other
No. Bedrooms 3 No. Bathrooms 2 No. Employees


☐ Slab ☒ Crawl Space ☐ Basement w/plumbing ☐ Basement wo/plumbing

Water Supply: ☐ Individual ☐ Community ☒ Public


Comments:

Comments:

INITIAL SITE SKETCH

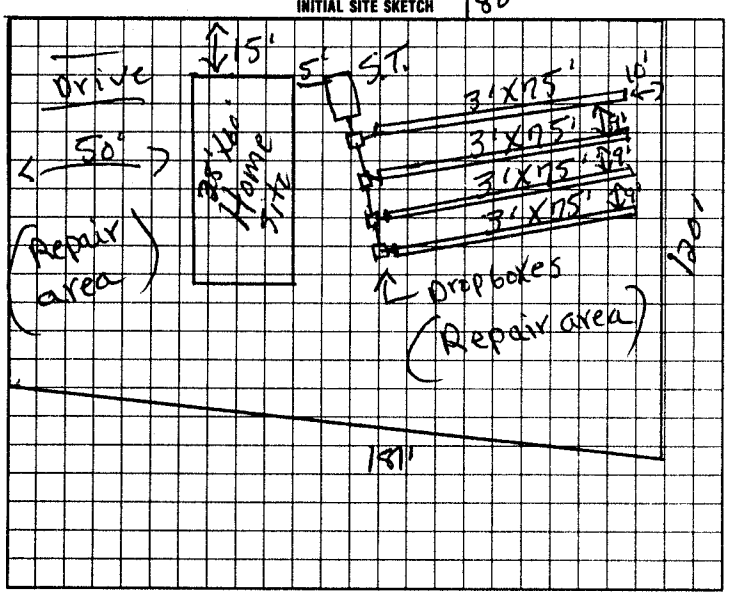

AS BUILT SKETCH

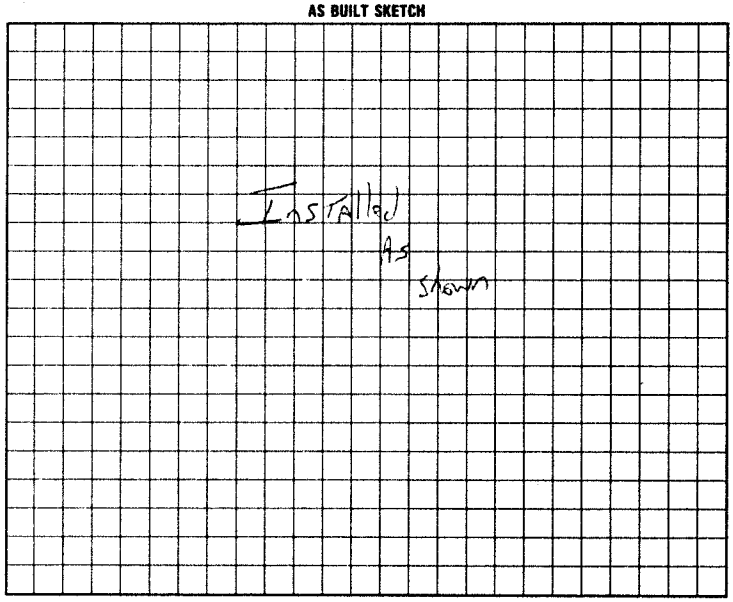

I understand that this permit can be suspended or revoked if any false information is supplied toward securing the permit/any unauthorized changes are made to the site/any unauthorized changes are made in the installation of the system. Improvement Permit is valid for 60 months from date of issuance.

Signed: T+T Co By H. Johnson

Improvement Permit by: L C Moore date 2-27-97

Existing System Inspection by: Authorization L. C. Moore date 2-27-97

Installed by: By Signature

Certificate of Completion by: Joe Potter date July 15, 00

Operation Permit by: date

HEALTH DEPT. COPY: WHITE INSPECTION COPY (FINAL): GREEN OWNER COPY (FINAL): YELLOW INSPECTION COPY (INITIAL): PINK OWNER COPY (INITIAL): GOLD

to Count. Authorization to Count EXPIRES 60 not to issue