IREDELL COUNTY HEALTH DEPARTMENT

Statesville Office (704) 878-5305 Mooresville Office (704) 660-3625 PERMIT # 210139

IMPROVEMENT PERMIT / AUTHORIZATION TO CONSTRUCT / OPERATION PERMIT / EXISTING SYSTEM

PIN # 4763-58-5381

APPLICANT: Joshuah Singleton APPLICANT ADDRESS: 138 Chick Ln Union Grove NC

SITE ADDRESS: 891 Bell Farm Rd PHONE: 704-738-7500 ALT. PHONE: 704-872-4534

SITE DIRECTIONS: Hwy 64 E, TRon Bell Farm, Lot on L

SUBDIVISION: Oak Creek SECTION: 1 LOT # 307 LOT AREA: 0.48 ac DESIGN FLOW: 360 L.T.A.R.: 0.3

Septic Tank Ex. 1000 (gal) STB Date

Pump Tank (gal) PT Date

Pump Make Model Serial #

Nitrification Fields 1 # Lines 4 Linear Ft: EXISTING

Trench Width 36" Max. Trench Bottom Depth EXISTING Gravel Depth

☐ New System ☐ Repair ☐ Expansion System Type: I II III IV V VI

System Description: Ex. 25% Reduction

Repair System Description: same

Maintenance Agreement Required: ☐ YES ☐ NO ☐ GRAVITY ☐ PRESSURE

☐ Residence ☐ Business ☒ Other ☐ Slab ☐ Basement w/plumbing

No. Bedrooms 3 No. Persons 6 No. Employees


☐ Crawl Space ☐ Basement w/o plumbing

Water Supply: ☐ Private ☒ Public ☐ Community


Comments / Conditions:

ADDITION OF A-Frame Roof to front porch, Addition of 4'x28' to Existing Deck, Addition of 12'x12' Porch with Lean-to

INITIAL SITE SKETCH

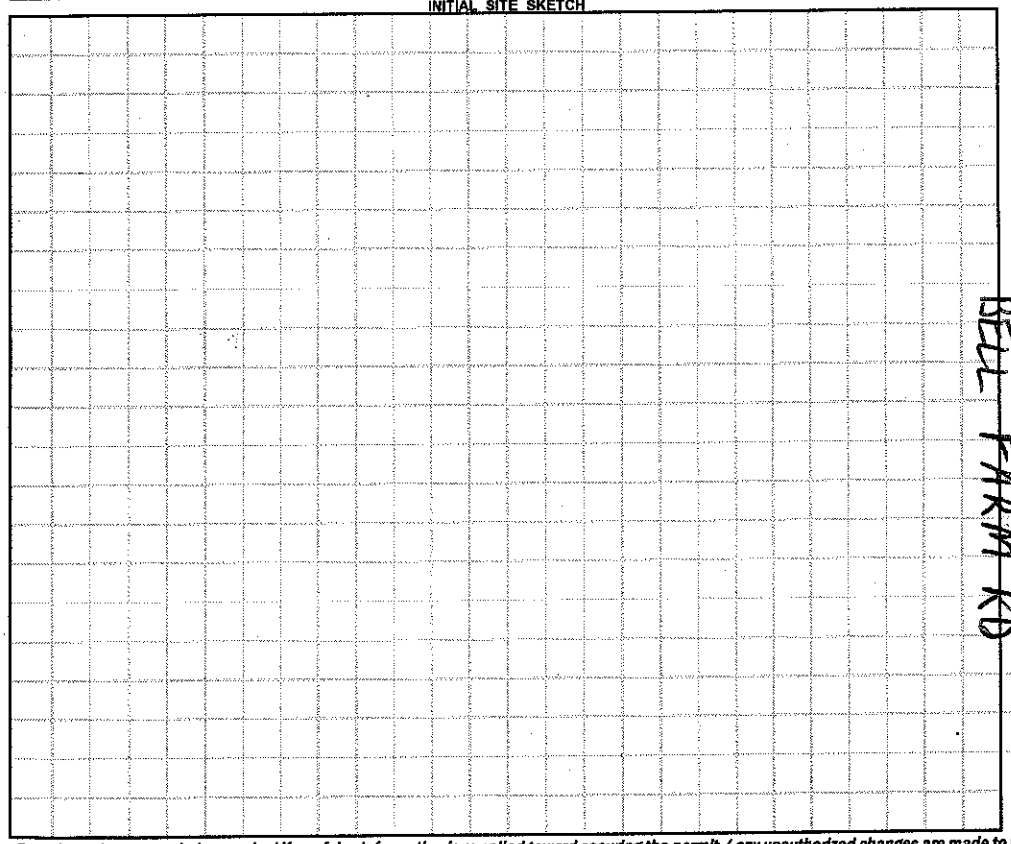

AS BUILT SKETCH

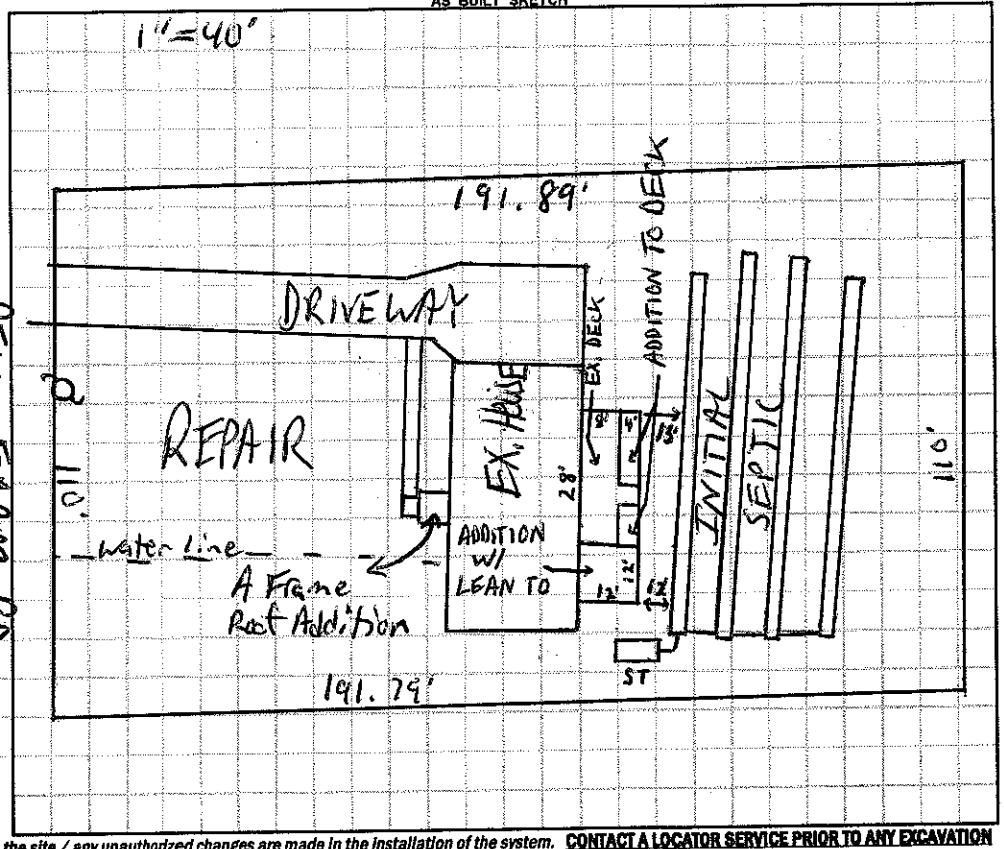

Permit can be suspended or revoked if any false information is supplied toward securing the permit / any unauthorized changes are made to the site / any unauthorized changes are made in the installation of the system. **CONTACT A LOCATOR SERVICE PRIOR TO ANY EXCAVATION**

☐ **IMPROVEMENT PERMIT** *with plan valid without expiration* ☐ **IMPROVEMENT PERMIT** *with site plan valid for 60 mos.* ☐ **AUTHORIZATION TO CONSTRUCT** *valid for period equal to IMPROVEMENT PERMIT--not to exceed 60 mo.*

Owner / Applicant Signature: Date: Installed by:

IMPROVEMENT PERMIT by: Date: OPERATION PERMIT by: Date:

AUTHORIZATION TO CONSTRUCT by: Date: Existing System Inspected by: Date: 5-26-15

Health Dept. Copy - WHITE Applicant (Final Approval) - YELLOW Applicant (Conditional Approval) - PINK