IREDELL COUNTY HEALTH DEPARTMENT

STATESVILLE 704-878-5305 MOORESVILLE 704-664-5281

IMPROVEMENT PERMIT / CERTIFICATE OF COMPLETION / OPERATION PERMIT / EXISTING SYSTEM INSPECTION

PROPERTY DESCRIPTION NO. 26028 DATE 2-14-97 TAX MAP NO. 4763-57-3335 Watershed: ☐ Yes ☑ No

OWNER OR CONTRACTOR T+T Inc. PHONE: Business 873-6660 Home

ADDRESS 849 Bell Fm Rd

LOCATION Bell Rd Turn oakCreeK TR Buckwheat 7th lot RT

SUBDIVISION OakCreeK BLOCK / SECTION II LOT 356 LOT AREA .4545 acs SITE CLASS. C5 DESIGN FLOW 360 L.T.A.R. .3

Septic Tank: 1000 Gallons; STB 1012 Date ~~12-26-96~~ 1-21-97 ☑ New System ☐ Repair System Type: I (II) III, IV, V, VI

Pump Tank: _____ Gallons; PT _____ Date _____ System Description: Conv. Gravity

Pump Make: _____ Model _____ Serial No. _____ Repair System Description: Pump To chambers

Nitrification Field: No Fields 1 Square Feet 1200 Linear Feet 400 Maintenance Agreement Required: ☐ Yes ☑ No

No Lines 5 Trench Width 36" Max Trench Bottom Depth 36" Gravel Depth 12"

☐ House/Mod. Home No. Bedrooms 3
☑ Mobile Home No. Bathrooms 2
☐ Business No. Employees ____
☐ Other


☐ Slab ☑ Crawl Space ☐ Basement w/plumbing ☐ Basement wo/plumbing

Water Supply: ☐ Individual ☐ Community ☑ Public


Comments:

Comments:

INITIAL SITE SKETCH

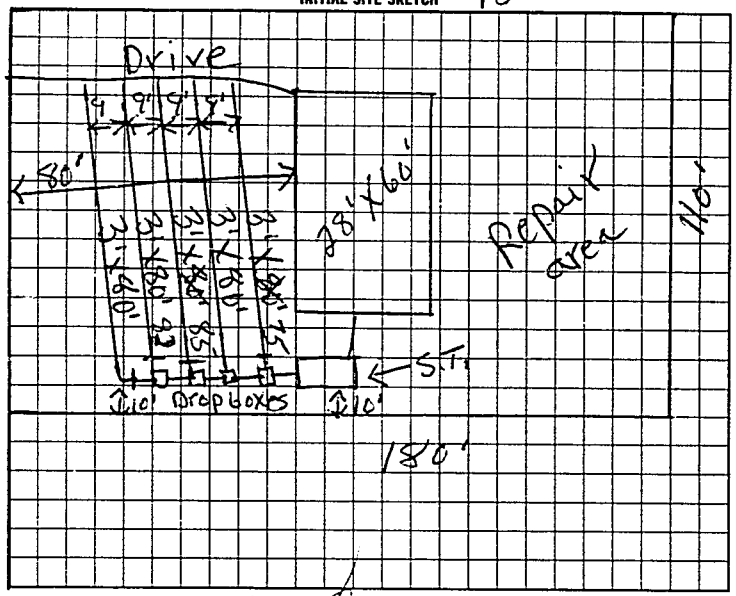

AS BUILT SKETCH

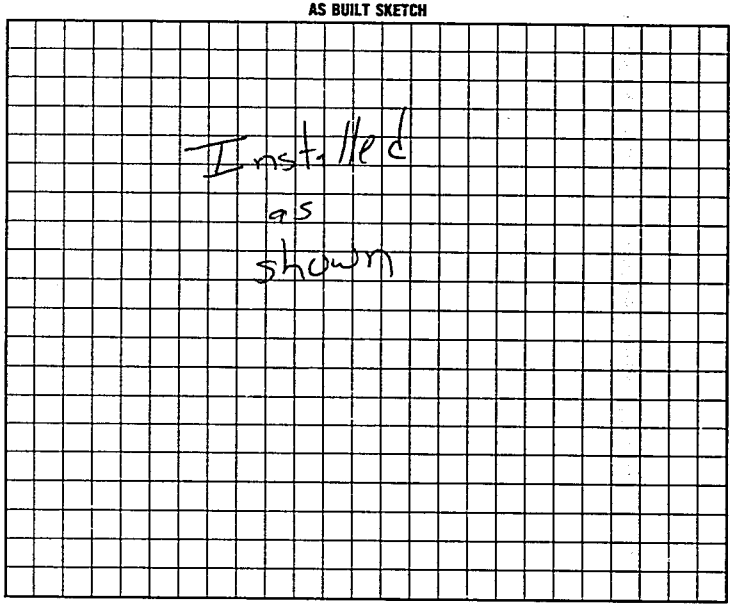

I understand that this permit can be suspended or revoked if any false information is supplied toward securing the permit/any unauthorized changes are made to the site/any unauthorized changes are made in the installation of the system. Improvement Permit is valid for 60 months from date of issuance.

Signed: _____

Improvement Permit by: D.C. Moore date 2-14-97

Existing System Inspection by: D.C. Moore date 2-14-97

Authorization to connect

Installed by: Donald Lacky

Certificate of Completion by: _____ date _____

Operation Permit by: Mark C.O.E. RS date 4-9-97

Authorization to Count EXPIRES 60 mos from issue

HEALTH DEPT COPY WHITE INSPECTION COPY (FINAL) GREEN OWNER COPY (FINAL) YELLOW INSPECTION COPY (INITIAL) PINK OWNER COPY (INITIAL) GOLD

9 6 2 0 0