IREDELL COUNTY HEALTH DEPARTMENT

STATESVILLE 704-878-5305 MOORESVILLE 704-664-5281

IMPROVEMENT PERMIT / CERTIFICATE OF COMPLETION / OPERATION PERMIT / EXISTING SYSTEM INSPECTION

PROPERTY DESCRIPTION NO. 26018 DATE 2-27-97 ~~TAX MAP NO.~~ pin 4763-57-3335 Watershed: ☐ Yes ☐ No

OWNER OR CONTRACTOR T+T Co Inc PHONE: Business 878-6660 Home

ADDRESS 849 Bell Fm Rd Statesville

LOCATION 64E TR Bell Rd TL oakcreek TR Buckwheat 8th lot left

SUBDIVISION Oakcreek BLOCK / SECTION LOT 346 LOT AREA 4545 SITE CLASS PS DESIGN FLOW 360 L.T.A.R. .13

Septic Tank: 1000 Gallons; STB 1012 Date 6-19-99
Pump Tank: Gallons; PT Date
Pump Make: Model Serial No.
Nitrification Field: No Fields 1 Square Feet 1200 Linear Feet 400
No Lines 4 Trench Width 36" Max Trench Bottom Depth 36" Gravel Depth 12"

☐ New System ☐ Repair System Type: ☐ I ☐ II ☐ III ☐ IV ☐ V ☐ VI
System Description: conv. Gravity
Repair System Description: Perus Plastic Panels
Maintenance Agreement Required: ☐ Yes ☐ No


☐ House/Mod. Home ☐ Mobile Home ☐ Business ☐ Other
No. Bedrooms 3 No. Bathrooms 2 No. Employees
☐ Slab ☐ Crawl Space ☐ Basement w/plumbing ☐ Basement wo/plumbing

Water Supply: ☐ Individual ☐ Community ☐ Public

Comments:

Comments:

INITIAL SITE SKETCH

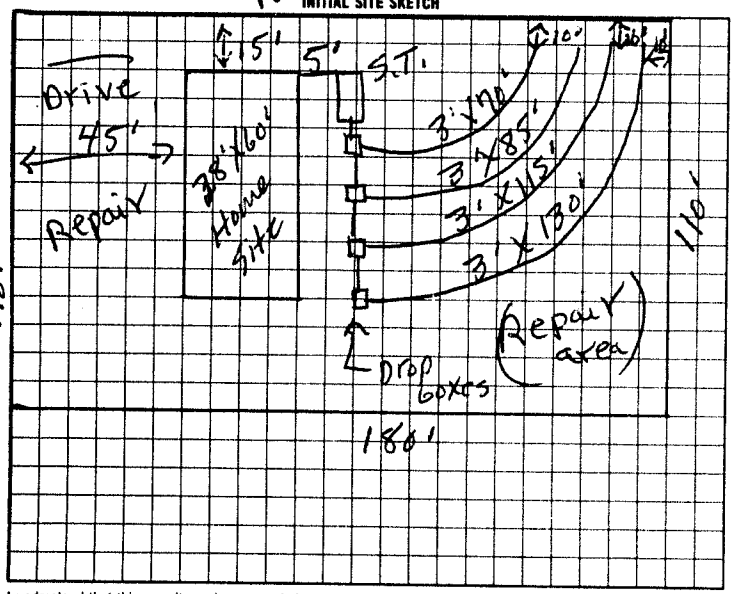

AS BUILT SKETCH

Same as initial sketch

I understand that this permit can be suspended or revoked if any false information is supplied toward securing the permit/any unauthorized changes are made to the site/any unauthorized changes are made in the installation of the system. Improvement Permit is valid for 60 months from date of issuance.

Signed:

Improvement Permit by: L.C. moore date 2-27-97 Installed by: Donald Farley

~~Existing System Inspection by:~~ Authorization for L.C. moore date 2-27-97 Certificate of Completion by: date

Operation Permit by: L.C. moore date 8-26-99

HEALTH DEPT. COPY: WHITE INSPECTION COPY (FINAL): GREEN OWNER COPY (FINAL): YELLOW INSPECTION COPY (INITIAL): PINK OWNER COPY (INITIAL): GOLD

To Const. Authorization to Const Expires 60 mos from Issue