IREDELL COUNTY HEALTH DEPARTMENT

STATESVILLE 704-878-5305 MOORESVILLE 704-664-5281

~~3:30~~ 9:30

IMPROVEMENT PERMIT / CERTIFICATE OF COMPLETION / OPERATION PERMIT / EXISTING SYSTEM INSPECTION

PROPERTY DESCRIPTION NO. 26030 DATE 2-14-97 TAX MAP NO. 4763-50-3335 Watershed: ☐ Yes ☒ No

OWNER OR CONTRACTOR TT Tco Inc. PHONE: Business 878-6660 Home

ADDRESS 849 Bell Farm Rd

LOCATION Bell Rd TR Oak Creek Rd TR Buckwheat Dr on 5th lot RT

SUBDIVISION Oak Creek BLOCK / SECTION II LOT 358 LOT AREA ~~.355~~ .4545 SITE CLASS. P5 DESIGN FLOW 360 L.T.A.R. .3

Septic Tank: 1000 Gallons; STB 1012 Date 12-20-96

Pump Tank: _____ Gallons; PT _____ Date _____

Pump Make: _____ Model _____ Serial No. _____

Nitrification Field: No Fields 1 Square Feet 1200 Linear Feet 400

No Lines 5 6 Trench Width 36" Max Trench Bottom Depth 36" Gravel Depth 12"

☒ New System ☐ Repair System Type: I, II, III, IV, V, VI

System Description: Conv. Gravity

Repair System Description: Pump To Chambers

Maintenance Agreement Required: ☐ Yes ☒ No

☐ House/Mod. Home ☒ Mobile Home ☐ Business ☐ Other

No. Bedrooms 3 No. Bathrooms 2 No. Employees _____


☐ Slab ☒ Crawl Space ☐ Basement w/plumbing ☐ Basement wo/plumbing

Water Supply: ☐ Individual ☐ Community ☒ Public


Comments:

Comments:

INITIAL SITE SKETCH

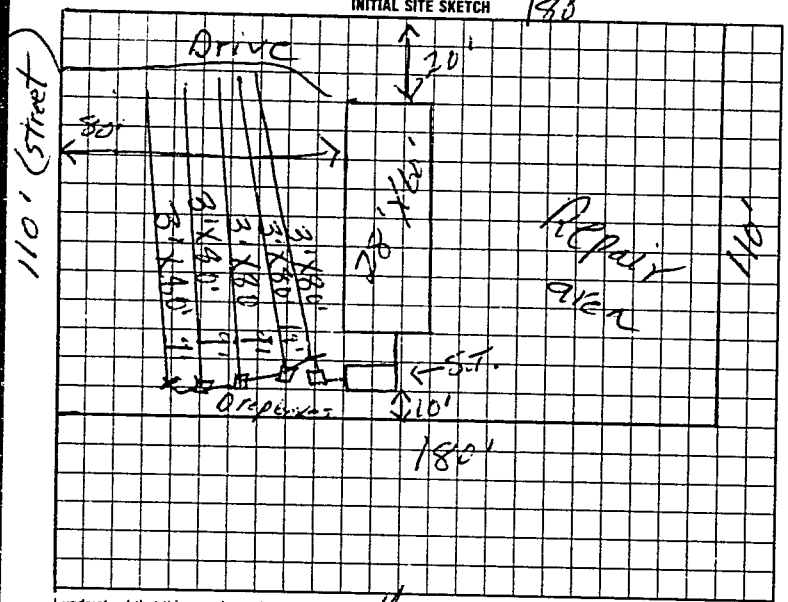

AS BUILT SKETCH

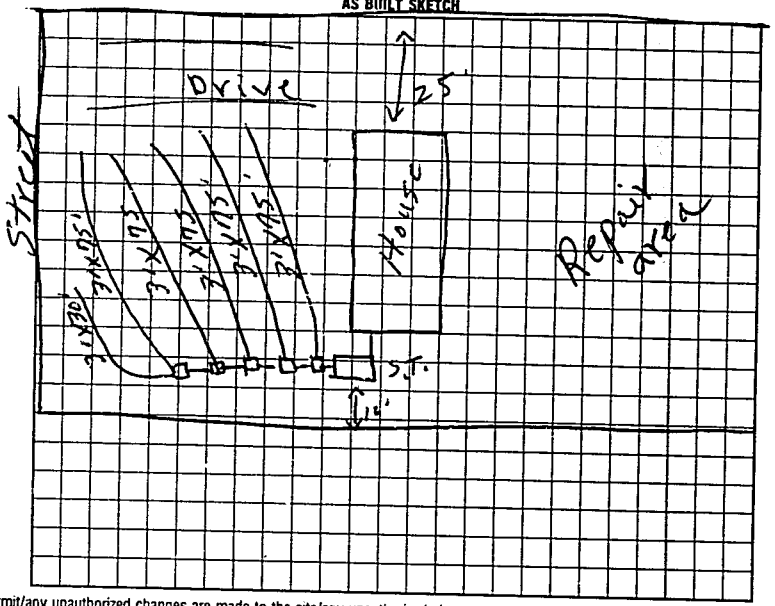

I understand that this permit can be suspended or revoked if any false information is supplied toward securing the permit/any unauthorized changes are made to the site/any unauthorized changes are made in the installation of the system. Improvement Permit is valid for 60 months from date of issuance.

Signed: _____

Improvement Permit by: L.C. Moore date 2-14-97

Authorization to Cover Existing System Inspection by: L.C. Moore date 2-14-97

Installed by: Donald Lackey

Certificate of Completion by: _____ date _____

Operation Permit by: L.C. Moore date 3-7-

HEALTH DEPT. COPY: WHITE INSPECTION COPY (FINAL): GREEN OWNER COPY (FINAL): YELLOW INSPECTION COPY (INITIAL): PINK OWNER COPY (INITIAL): GOLD

Authorization to Cover Expires 60 mos from 2-14-97

2000