TO OLD TO CALL IN -7 CI

IREDELL COUNTY HEALTH DEPARTMENT

STATESVILLE 704-878-5305 MOORESVILLE 704-664-5281

IMPROVEMENT PERMIT / CERTIFICATE OF COMPLETION / OPERATION PERMIT / EXISTING SYSTEM INSPECTION

PROPERTY DESCRIPTION NO. ~~2603T~~ 103909 DATE 2-14-97 TAX MAP NO. 4763-57-3335 Watershed: ☐ Yes ☒ No

OWNER OR CONTRACTOR T+T Co Inc. PHONE: Business 878-6660 Home

ADDRESS 849 Bell Farm Rd

LOCATION Bell Rd Turn oakcreek Rd TR Buckwheat 4th lot Rt

SUBDIVISION oakcreek BLOCK / SECTION LOT 359 LOT AREA .4545acs SITE CLASS P3 DESIGN FLOW 360 L.T.A.R. .3

Septic Tank: 1000 Gallons; STB 1012 Date 8-19-01
Pump Tank: Gallons; PT Date
Pump Make: Model Serial No.
Nitrification Field: No Fields 1 Square Feet 1200 Linear Feet 400
No Lines 5 Trench Width 36" Max Trench Bottom Depth 36" Gravel Depth 12"

☒ New System ☐ Repair System Type: I (II) III, IV, V, VI
System Description: Conv. Gravity
Repair System Description: Pump to Chambers
Maintenance Agreement Required: ☐ Yes ☒ No
☐ Slab ☒ Crawl Space ☐ Basement w/plumbing ☐ Basement wo/plumbing


☐ House/Mod. Home No. Bedrooms 3
☒ Mobile Home No. Bathrooms 2
☐ Business No. Employees
☐ Other

Water Supply: ☐ Individual ☐ Community ☒ Public

Comments:

Comments: POLYLOK FILTER & MACICARC INSTALLED AS SHOWN.

INITIAL SITE SKETCH

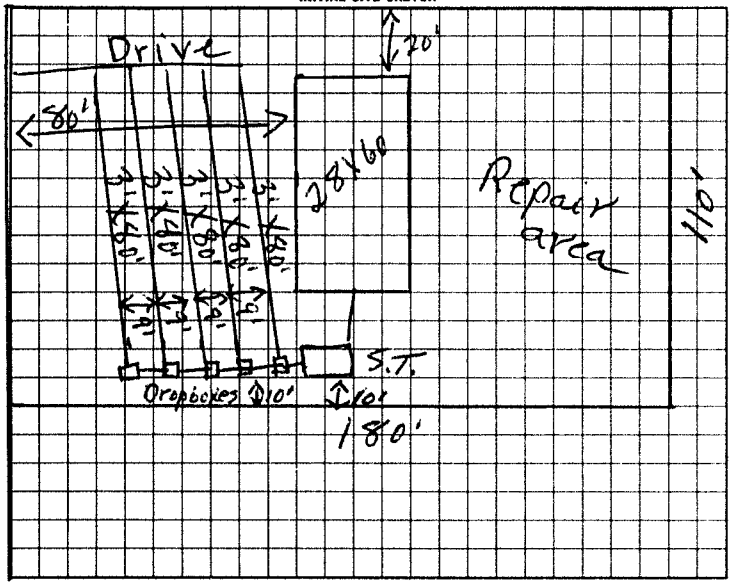

AS BUILT SKETCH

INITIAL DRAWING OUT OF CONTOUR, INSTALLED AS DRAWN WITH PROPER AMOUNT OF COVER.

I understand that this permit can be suspended or revoked if any false information is supplied toward securing the permit/any unauthorized changes are made to the site/any unauthorized changes are made in the installation of the system. Improvement Permit is valid for 60 months from date of issuance.

Signed:

Improvement Permit by: P.C. Moore date 2-14-97
Authorization to count.
Existing System Inspection by: P.C. Moore date 2-14-97

Installed by: A-1 BACKHOE
Certificate of Completion by: date 12/7/01
Operation Permit by: date

HEALTH DEPT. COPY: WHITE INSPECTION COPY (FINAL): GREEN OWNER COPY (FINAL): YELLOW INSPECTION COPY (INITIAL): PINK OWNER COPY (INITIAL): GOLD

Authorization to count. EXPIRES 60 mos from issue