IREDELL COUNTY HEALTH DEPARTMENT

STATESVILLE 704-878-5305 MOORESVILLE 704-664-5281

IMPROVEMENT PERMIT / AUTHORIZATION TO CONSTRUCT / OPERATION PERMIT / EXISTING SYSTEM INSPECTION

PERMIT# _____ PIN# 4763-59-2952 DATE 03-28-03

OWNER OR CONTRACTOR DEAN WEAVER PHONE: Business 7 Home 704-883-0973

ADDRESS 196 BELLWOOD LOOP STATESVILLE NC 28625

LOCATION 64 EAST (2) BELLEVIEW RD (3) BELLWOOD DRIVE, AROUND LOOP (4) AT BOX # 196

SUBDIVISION BELLWOOD BLOCK / SECTION _____ LOT 19 LOT AREA _____ SITE CLASS. _____ DESIGN FLOW _____ L.T.A.R. _____

Septic Tank: EXISTING Gallons; STB _____ Date _____

Pump Tank: _____ Gallons; PT _____ Date _____

Pump Make: _____ Model _____ Serial No. _____

Nitrification Field: No Fields 1 Square Feet _____ Linear Feet 160'

No Lines 2x80' Trench Width 36" Max Trench Bottom Depth 36" Gravel Depth 12"

☐ New System ☒ Repair System Type: I, (II), III, IV, V, VI

System Description: CONV GRAV

Repair System Description: _____

Maintenance Agreement Required: ☐ Yes ☐ No

☒ House/Mod. Home No. Bedrooms 3

☐ Mobile Home No. Bathrooms 1½

☐ Business No. Employees ____

☐ Other _____


☐ Slab ☐ Crawl Space ☐ Basement w/plumbing ☐ Basement wo/plumbing

Water Supply: ☐ Individual ☒ Public ☐ Community BOTH WELL

Comments:/Conditions: (1) INSTALL 2 NEW LINES 80' LONG SPLIT FED WITH DROP BOXES (2) SYSTEM IS FLAGGED (3) INSTALL SURFACE DIVERSION DITCH AS DRAWN (4) LOT HAS EXTREMELY

Comments:/Conditions: POOR SOILS: BEST PROFESSIONAL JUDGEMENT WAS USED TO DETERMINE THIS REPAIR. (5) THIS PERMIT SERVES AS NOTICE OF VIOLATION AND MUST BE REPAIRED WITHIN 30 DAYS.

INITIAL SITE SKETCH

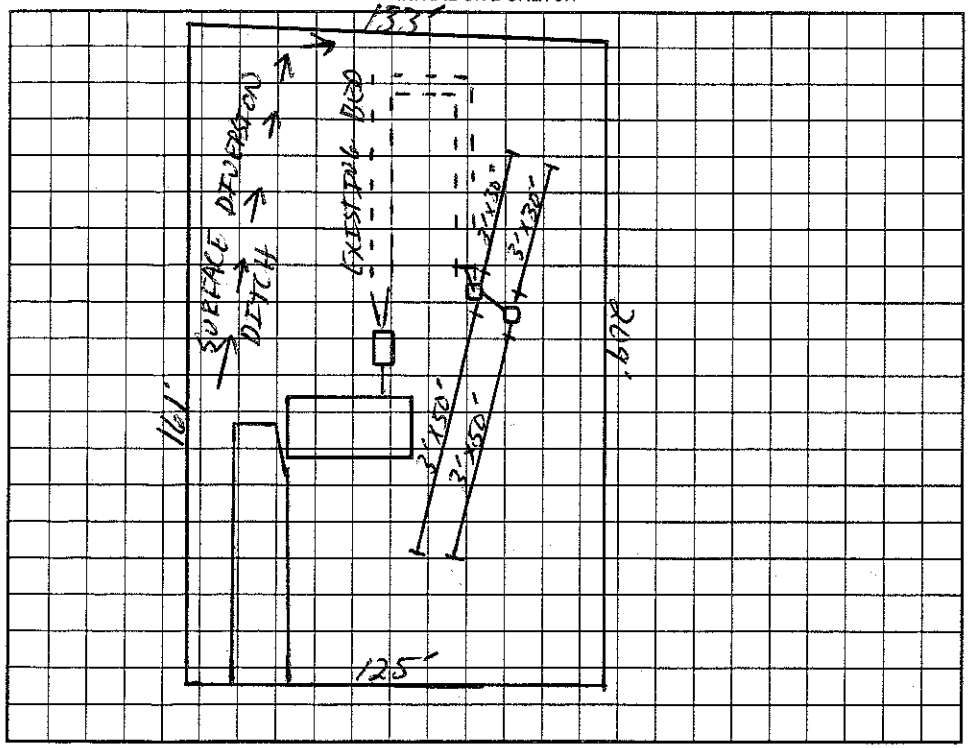

AS BUILT SKETCH

SYSTEM REPAIRED ACCORDING TO INITIAL SITE SKETCH

Permit can be suspended or revoked if any false information is supplied toward securing the permit/any unauthorized changes are made to the site/any unauthorized changes are made in the installation of the system. Improvement Permit with plat valid without expiration. Improvement Permit with site plan valid for sixty months. Authorization to Construct is valid for a period equal to that of Improvement Permit – not to exceed sixty months.

Signed: _____ date 03-28-03 Installed by: STEVE JORDAN

Improvement Permit by: _____ date 03-28-03 Operation Permit by: STEVE HEDRICK date 10-24-03

Authorization to Construct by: _____ date 03-28-03 Existing System Inspection by: _____ date _____

HEALTH DEPT. COPY: WHITE OWNER COPY (FINAL): YELLOW OWNER COPY (INITIAL): PINK