IREDELL COUNTY HEALTH DEPARTMENT

STATESVILLE 704-878-5305 MOORESVILLE 704-664-5281

IMPROVEMENT PERMIT / AUTHORIZATION TO CONSTRUCT / OPERATION PERMIT / EXISTING SYSTEM INSPECTION

PERMIT# REPAIR PIN# 4763-59-4029 5048 DATE 6-26-03

OWNER OR CONTRACTOR MARGIE SHARPE PHONE: Business Home 704-873-3826

ADDRESS 848 BELL FARM ROAD STATESVILLE NC 28625

LOCATION US 64 EAST, TR BELL FARM ROAD 2ND HOUSE ON RIGHT PAST STEEP LANE AT #848

SUBDIVISION BLOCK / SECTION LOT LOT AREA 5.30 ACRES SITE CLASS. PS DESIGN FLOW 360 L.T.A.R. EXISTING

Septic Tank: EXISTING Gallons; STB Date

Pump Tank: Gallons; PT Date

Pump Make: Model Serial No.

Nitrification Field: No Fields 1 Square Feet 450 Linear Feet 150

No Lines TWO Trench Width 36" Max Trench Bottom Depth 36" Gravel Depth 12"

☐ New System ☑ Repair System Type: I, II, III, IV, V, VI

System Description:

Repair System Description: CONVENTIONAL GRAVITY

Maintenance Agreement Required: ☐ Yes ☑ No

☑ House/Mod. Home No. Bedrooms 3

☐ Mobile Home No. Bathrooms 2

☐ Business No. Employees

☐ Other


☐ Slab ☑ Crawl Space ☑ Basement w/plumbing ☐ Basement wo/plumbing

Water Supply: ☑ Individual ☐ Public ☐ Community


Comments:/Conditions: INSTALL NEW SCHEDULE 40 PVC SUPPLY LINE AS SHOWN TO TWO NEW DROP BOXES FEEDING EXISTING LINE PLUS TWO NEW 3'x 75' LINES

Comments:/Conditions: FOR MAINTENANCE, USE 32 OUNCES COPPER SULFATE IN DRAINS ANNUALLY TO CONTROL ROOT GROWTH

INITIAL SITE SKETCH

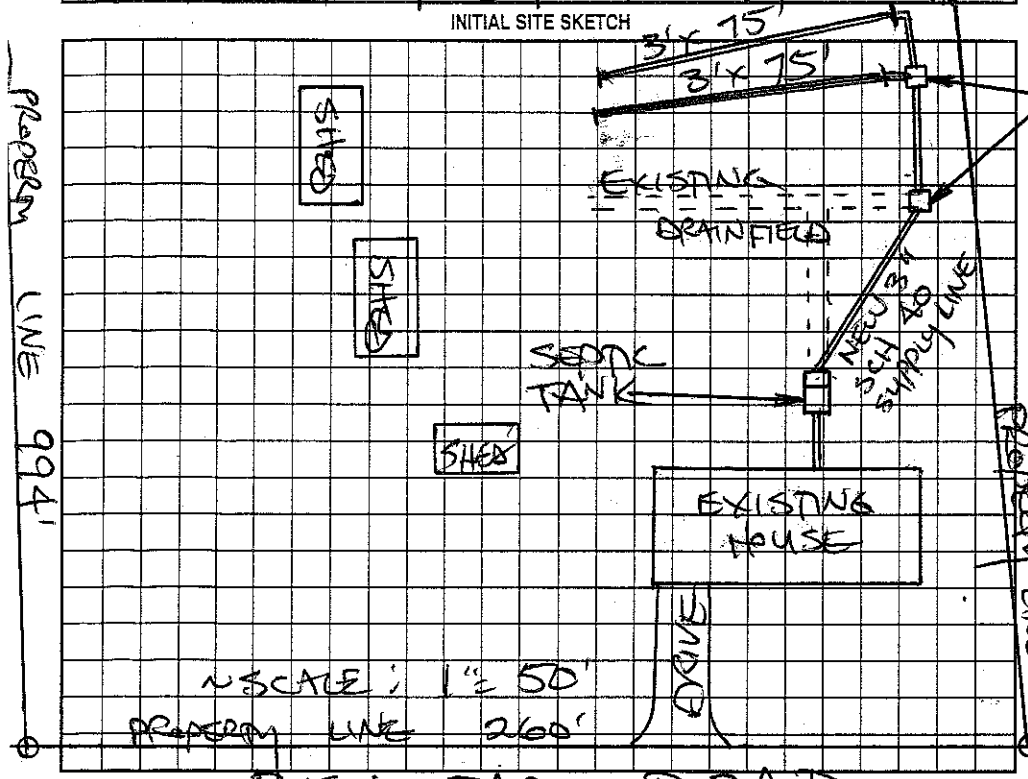

AS BUILT SKETCH

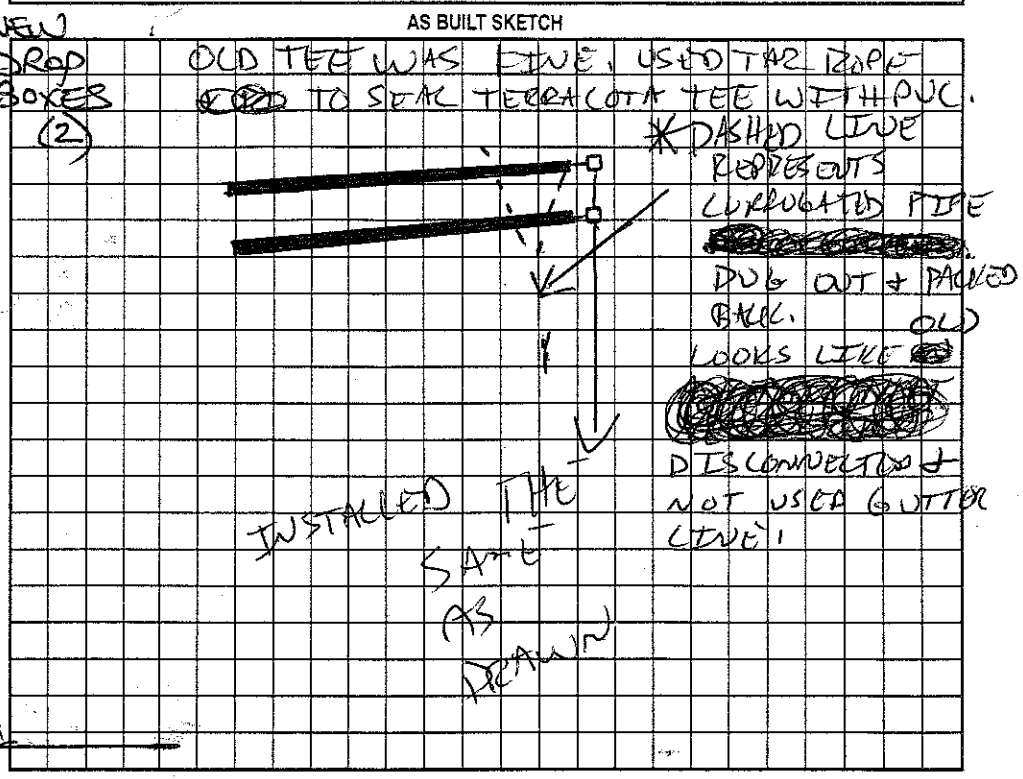

Permit can be suspended or revoked if any false information is supplied toward securing the permit/any unauthorized changes are made to the site/any unauthorized changes are made in the installation of the system. Improvement Permit with plat valid without expiration. Improvement Permit with site plan valid for sixty months. Authorization to Construct is valid for a period equal to that of Improvement Permit – not to exceed sixty months.

Signed: X Waverly S Rose date 6-26-03 Installed by: CRAIG THOMPSON

Improvement Permit by: STEVE HEDRICK date 6-26-03 Operation Permit by: date

Authorization to Construct by: STEVE HEDRICK date 6-26-03 Existing System Inspection by: date

HEALTH DEPT. COPY: WHITE OWNER COPY (FINAL): YELLOW OWNER COPY (INITIAL): PINK