29

IREDELL COUNTY HEALTH DEPARTMENT - *ENVIRONMENTAL HEALTH* ☒ STATESVILLE OFFICE 704-878-5305 ☐ MOORESVILLE OFFICE 704-664-5281

IMPROVEMENT PERMIT / AUTHORIZATION TO CONSTRUCT / OPERATION PERMIT / EXISTING SYSTEM INSPECTION

PERMIT # Repair PIN # 4763-59-8159 DATE 1-10-12

OWNER Geniece McKinney APPLICANT: Joshua McKinney PHONE: Home/Cell # 704-239-1717 Business #

SITE ADDRESS 842 Bell Farm OWNER / APPLICANT ADDRESS:

SITE DIRECTIONS 64E, (R) on Bell Farm, on (R) @ Bell Farm and Steep

SUBDIVISION n/a BLOCK / SECTION n/a LOT # n/a LOT AREA .85 Ac DESIGN FLOW 360 L.T.A.R. Ex

Septic Tank 1000 Gallons: STB 825 Date 11-18-11 ☐ New System ☒ Repair ☐ Expansion System Type I (II) III IV V VI ☒ Residence No. Bedrooms 3 Water Supply

Pump Tank ____ Gallons: P T ____ Date ____ System Description: TANK ☐ Business No. Persons ____ ☒ Private

Pump Make ____ Model ____ Serial # ____ Repair System Description: ☐ Other No. Employees ____ ☐ Public


No. Nitrification Fields: Ex No. Lines Ex Linear Feet Ex Maintenance Agreement Required ☐ YES ☒ NO ☐ Slab ☒ Crawl Space ☐ Community

Trench Width Ex Max. Trench Bottom Depth Ex Gravel Depth Ex ☒ GRAVITY ☐ PRESSURE ☐ Basement w/plumbing ☐ Basement w/o plumbing

Comments / Conditions

211

INITIAL SITE SKETCH

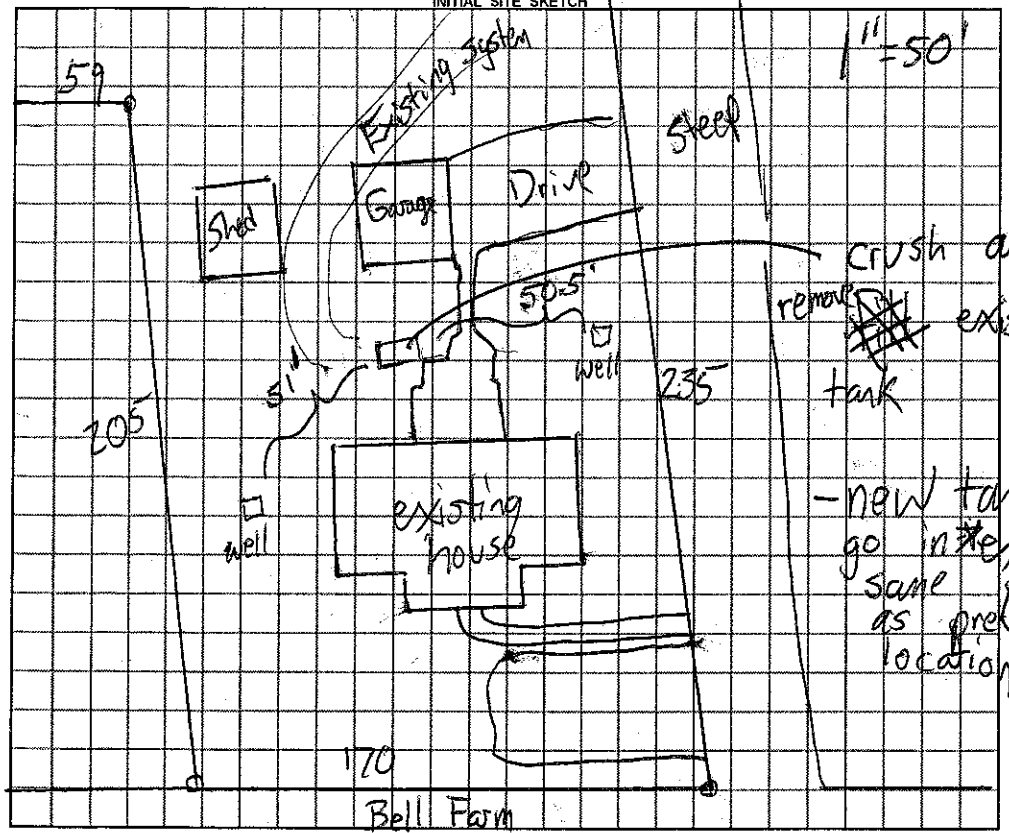

AS BUILT SKETCH

Permit can be suspended or revoked if any false information is supplied toward securing the permit / any unauthorized changes are made to the site / any unauthorized changes are made in the installation of the system.

☐ ***IMPROVEMENT PERMIT*** with plat valid without expiration. ☒ ***IMPROVEMENT PERMIT*** with plat ~~valid without expiration~~ site plan valid 60 mo. ☒ ***AUTHORIZATION TO CONSTRUCT*** valid for period equal to IMPROVEMENT PERMIT--not to exceed 60 mo.

Owner / Applicant Signature: Geniece McKinney Date 1-10-12 Installed by: Rowan Septic

IMPROVEMENT PERMIT by: James REHS Date 1-10-12 OPERATION PERMIT by: James REHS Date 1-20-12

AUTHORIZATION TO CONSTRUCT by: James REHS Date 1-10-12 Existing System Inspected by: / REHS Date

YOU SHOULD CONTACT A LOCATOR SERVICE PRIOR TO ANY EXCAVATION

White Copy – Environmental Health YELLOW COPY (Final) Owner / Applicant PINK COPY (Initial) Owner / Applicant