IREDELL COUNTY HEALTH DEPARTMENT

STATESVILLE 704-878-5305 MOORESVILLE 704-664-5281

IMPROVEMENT PERMIT / AUTHORIZATION TO CONSTRUCT / OPERATION PERMIT / EXISTING SYSTEM INSPECTION

PERMIT# _____ PIN# _____ DATE 5-7-98

OWNER OR CONTRACTOR George Myszak PHONE: Business _____ Home 872-6734

ADDRESS 842 Bell Farm Rd

LOCATION NO E TL Bell Farm corner Steep Ln.

SUBDIVISION _____ BLOCK / SECTION _____ LOT _____ LOT AREA 1 acre+ SITE CLASS. PS DESIGN FLOW 360 L.T.A.R. .2

Septic Tank: 1000 Gallons; STB _____ Date _____

Pump Tank: _____ Gallons; PT _____ Date _____

Pump Make: _____ Model _____ Serial No. _____

Nitrification Field: No Fields 1 Square Feet 900 Linear Feet 300

No Lines 4 Trench Width 36" Max Trench Bottom Depth 36" Gravel Depth 12"

☐ New System ☑ Repair System Type: I, II, III, IV, V, VI

System Description: _____

Repair System Description: Conv. Gravity

Maintenance Agreement Required: ☐ Yes ☑ No

☑ House/Mod. Home No. Bedrooms 3

☐ Mobile Home No. Bathrooms 2

☐ Business No. Employees _____

☐ Other _____


☐ Slab ☑ Crawl Space ☐ Basement w/plumbing ☐ Basement wo/plumbing

Water Supply: ☑ Individual ☐ Public ☐ Community

Comments:/Conditions: Check S.T. Replace If necessary.

Comments:/Conditions:

INITIAL SITE SKETCH

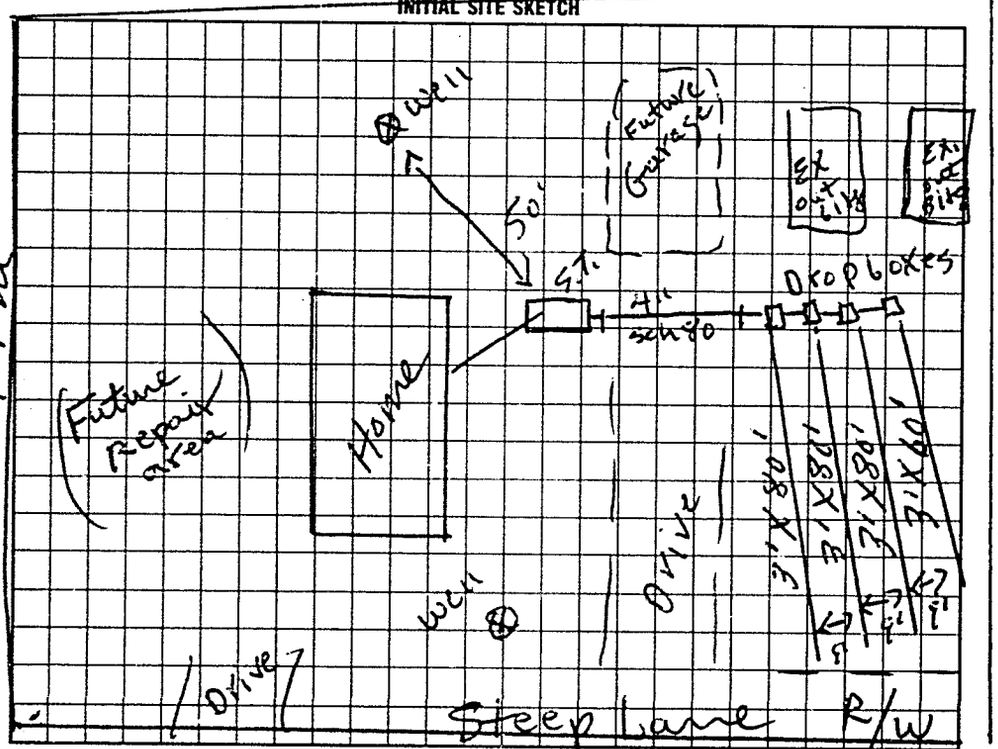

AS BUILT SKETCH

Installed as shown

I understand that this permit can be suspended or revoked if any false information is supplied toward securing the permit/any unauthorized changes are made to the site/any unauthorized changes are made in the installation of the system. Improvement Permit with plat valid without expiration. Improvement Permit with site plan valid for sixty months. Authorization to Construct is valid for a period equal to that of Improvement Permit – not to exceed sixty months.

Signed: George Myszak date _____ Installed by: Wards Backhoe Service

Improvement Permit by: E.C. Moore date 5-7-98 Operation Permit by: Mary C Outlaw date 5-19-98

Authorization to Construct by: E.C. Moore date 5-7-98 Existing System Inspection by: _____ date _____

HEALTH DEPT COPY WHITE INSPECTION COPY (FINAL) GREEN OWNER COPY (FINAL) YELLOW INSPECTION COPY (INITIAL) PINK OWNER COPY (INITIAL) GOLD

L 9 8 2 0 0