IREDELL COUNTY HEALTH DEPARTMENT STATESVILLE 704-878-5305 MOORESVILLE 704-664-5281 (ad)

IMPROVEMENT PERMIT / AUTHORIZATION TO CONSTRUCT / OPERATION PERMIT / EXISTING SYSTEM INSPECTION

PERMIT # 155838 PIN # 4763 60 6780 DATE 21 April 09

OWNER or APPLICANT Rodney & Ladonna Bryant PHONE: Business Home: 828-465-3450

OWNER or APPLICANT ADDRESS 138 Island Sycamore Drive Statesville NC 28677

LOCATION / DIRECTIONS Bethesda RD, right (TR) Treeline, (TR) Arbor (TR) Island Sycamore

SUBDIVISION Forest Acres BLOCK / SECTION LOT # 149 LOT AREA DESIGN FLOW 240 L.T.A.R. Exist

Septic Tank Exist	Gallons: STB Exist	Date Exist	☐ ~~New System~~ ☐ Repair ☐ Expansion System Type I II (III) IV V VI	☑ Residence No. Bedrooms 2	Water Supply
Pump Tank	Gallons: PT	Date	System Description: Existing T & J Gravel 100 ln ft	☐ Business No. Persons	☐ Private
Pump Make	Model	Serial #	Repair System Description: Pump T & J 50% red.	☐ Other No. Employees	☑ Public
Nitrification Field No Fields	No Lines 2 + pt Linear Feet		Maintenance Agreement Required ☐ YES ☐ NO	☐ Slab ☑ Crawl Space	☐ Community
Trench Width 24	Max. Trench Bottom Depth 36+	Gravel Depth NA	☐ GRAVITY ☐ PRESSURE	☐ Basement w/plumbing ☐ Basement w/o plumbing	

Comments / Conditions


Stub out high to achieve fall to tank

Switching (2 Bedroom SW) for (2 Bedroom DW)

INITIAL SITE SKETCH

Comments / Conditions

AS BUILT SKETCH

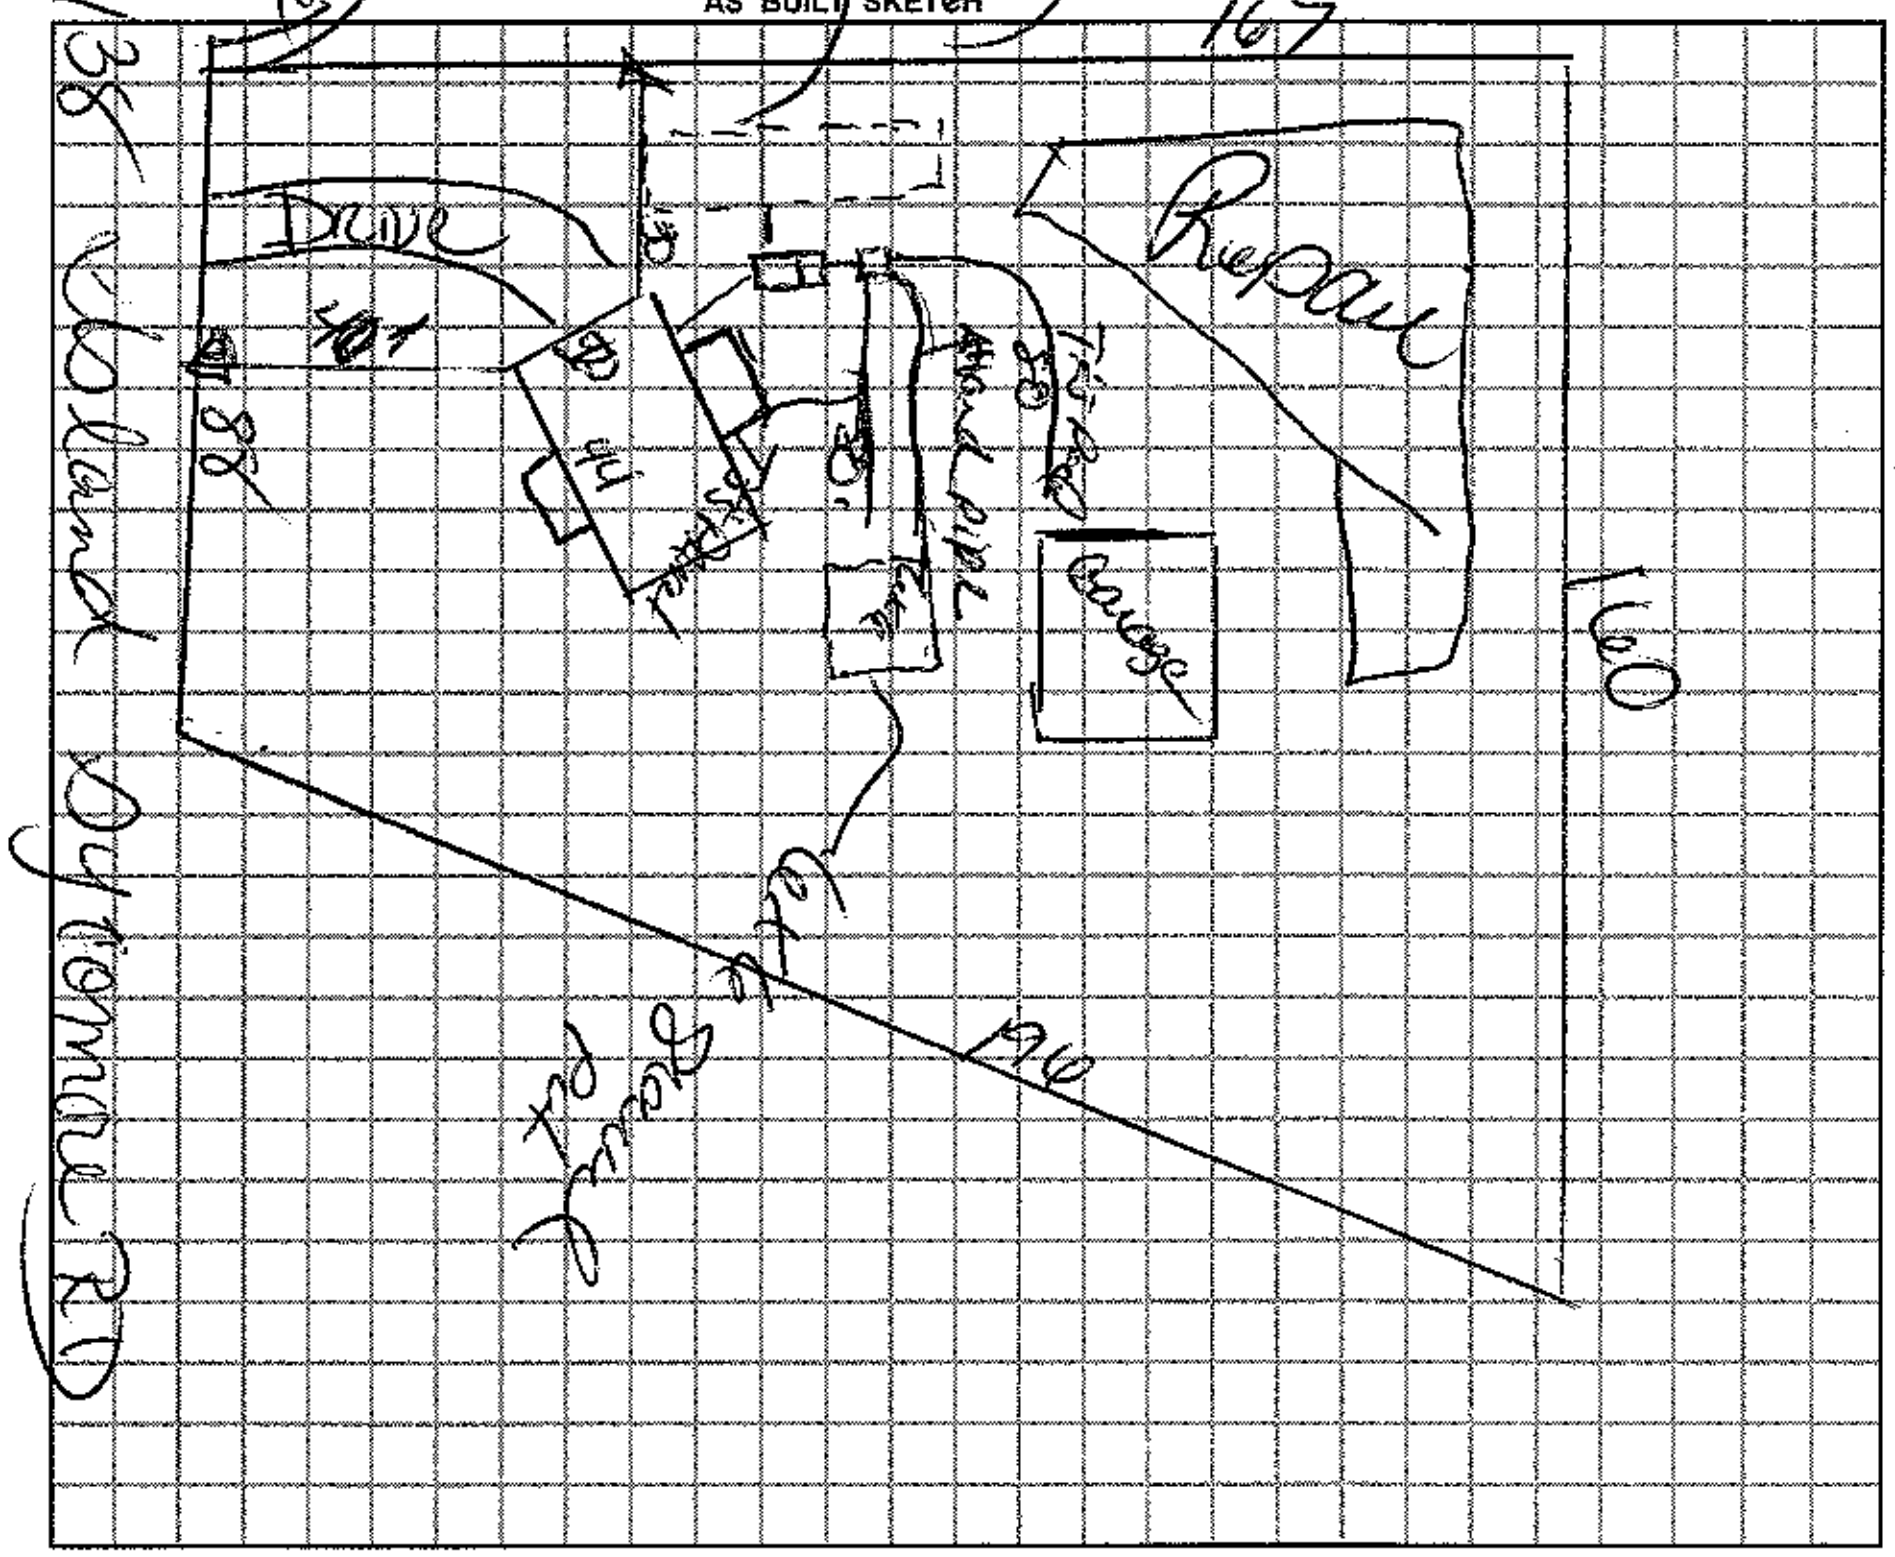

Permit can be suspended or revoked if any false information is supplied toward securing the permit / any unauthorized changes are made to the site / any unauthorized changes are made in the installation of the system.

☐ *IMPROVEMENT PERMIT w / plat valid without expiration.* ☐ *IMPROVEMENT PERMIT w / site plan valid for 60 mos.* ☑ *AUTHORIZATION TO CONSTRUCT valid for period equal to IMPROVEMENT PERMIT-not to exceed 60 mo.*

Owner / Applicant Signature: [signature] Date 5-15-09 Installed by:

Improvement Permit by: Date Operation Permit by: Date:

Authorzation to Construct by: Date Existing System Inspected by: Kenny Cook Date: 21 April 09

YOU SHOULD CONTACT A LOCATOR SERVICE PRIOR TO ANY EXCAVATION.

WHITE COPY Environmental Health YELLOW COPY (Final) Owner / Applicant PINK COPY (Initial) Owner / Applicant