IREDELL COUNTY HEALTH DEPARTMENT

STATESVILLE 704-878-5305 MOORESVILLE 704-664-5281

IMPROVEMENT PERMIT / AUTHORIZATION TO CONSTRUCT / OPERATION PERMIT / EXISTING SYSTEM INSPECTION

PERMIT# 105303 PIN# 4763-61-0464 DATE 3-22-02

OWNER OR CONTRACTOR DEBBIE CASEY TSUMAS FAMILY LTD. PARTNERSHIP PHONE: Business 704-878-9171 Home

ADDRESS 300 E. BROAD ST, STATESVILLE, NC 28677 (SUITE 102)

LOCATION US 70 E, TR BETHESDA, TL TREELINE, TR ARBOR DRIVE, LOT ON RIGHT AT CURVE

SUBDIVISION FOREST ACRES BLOCK / SECTION LOT 165 LOT AREA LIMITED SITE CLASS PS DESIGN FLOW 360 L.T.A.R. 0.25 GAD/PT

Septic Tank: EXISTING Gallons: STB Date

Pump Tank: Gallons: PT Date

Pump Make: Model Serial No.

Nitrification Field: No Fields 1 Square Feet 540 Linear Feet 180

No Lines TWO Trench Width 36" Max Trench Bottom Depth 36" Gravel Depth N/A

☒ New System ☐ Repair System Type: I. II (III) IV. V

System Description: 25% REDUCTION, GRAVITY

Repair System Description: 50% REDUCTION, LOW PRESSURE

Maintenance Agreement Required: ☐ Yes ☒ No

☐ House/Mod. Home ☒ Mobile Home ☐ Business ☐ Other

No. Bedrooms ~~3~~ 2 No. Bathrooms 2 No. Employees


Water Supply: ☐ Individual ☒ Public ☐ Community

☐ Slab ☐ Crawl Space ☐ Basement w/plumbing ☐ Basement wo/plumbing


Comments/Conditions: ① PUMP OUT SEPTIC TANK ② REPAIR EXISTING DISTRIBUTION BOX WITH SERIES OF DROP BOXES AS SHOWN ③ INSTALL TWO NEW 3' x 90' LINES USING 25% REDUCTION SYSTEM

Comments/Conditions: - SYSTEM SIZED FOR TWO (2) BEDROOMS ONLY. DID NOT INSTALL TWO (2) NEW LINES

INITIAL SITE SKETCH

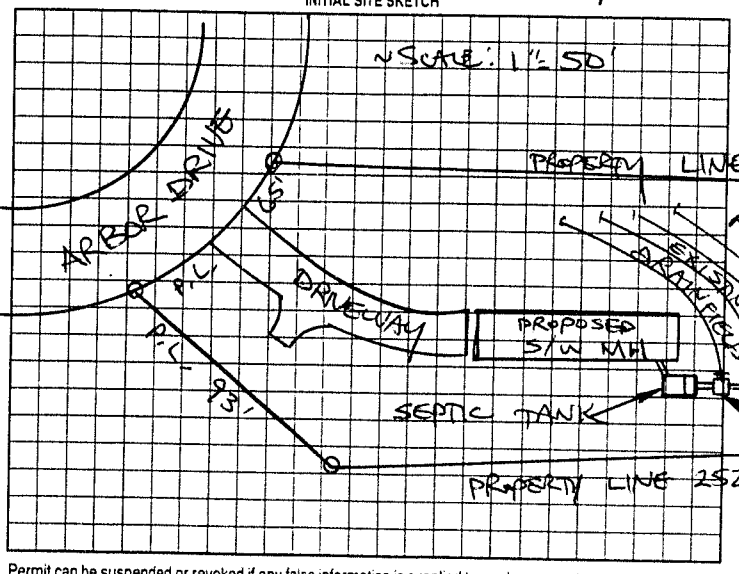

AS BUILT SKETCH

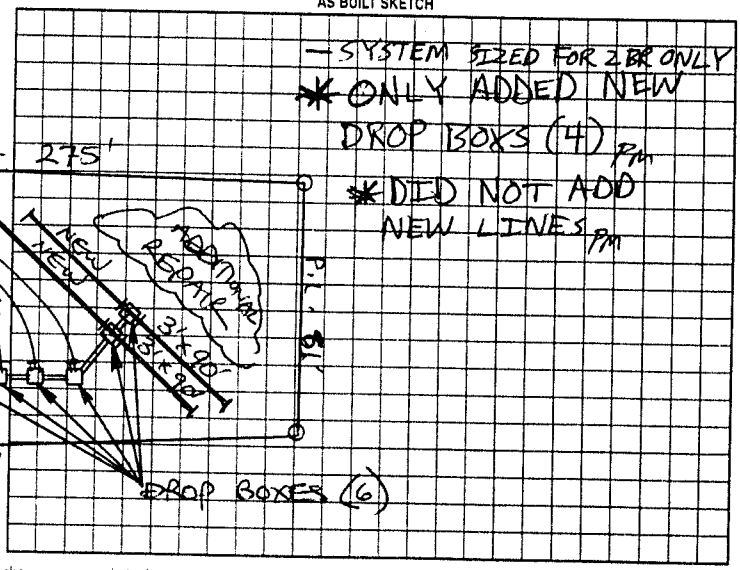

Permit can be suspended or revoked if any false information is supplied toward securing the permit/any unauthorized changes are made to the site/any unauthorized changes are made in the installation of the system. Improvement Permit with plat valid without expiration. Improvement Permit with site plan valid for sixty months. Authorization to Construct is valid for a period equal to that of Improvement Permit – not to exceed sixty months.

Signed: Jan K Murdock date 3-25-02 Installed by: LANCE LINGLES

Improvement Permit by: STEVE HENDRICK date 3-22-02 Operation Permit by: Patricia Mitchell date 09/04/02

Authorization to Construct by: STEVE HENDRICK date 3-22-02 Existing System Inspection by: date

HEALTH DEPT. COPY: WHITE OWNER COPY (FINAL): YELLOW OWNER COPY (INITIAL): PINK