IREDELL COUNTY HEALTH DEPARTMENT

Statesville Office (704) 878-5305 | Mooresville Office (704) 660-3625 | PERMIT # 207599

FILE COPY

IMPROVEMENT PERMIT / AUTHORIZATION TO CONSTRUCT / OPERATION PERMIT / EXISTING SYSTEM

PIN # 4763610464

APPLICANT: James Pearson | APPLICANT ADDRESS: 311 Lyttonst Troutman NC 28166

SITE ADDRESS: 144 Arbor Dr Statesville NC | PHONE: 704-253-3575 | ALT. PHONE: N/A

SITE DIRECTIONS: 70 E to Bethesda Rd T/L Treeline Dr T/R Arbor Dr Lot on right

SUBDIVISION: Forest Acres | SECTION: M2 | LOT # 165 | LOT AREA: 0.64ac | DESIGN FLOW: 240 | L.T.A.R.: Ex

Septic Tank Ex (gal) | STB | Date

Pump Tank (gal) | PT | Date

Pump Make | Model | Serial #

Nitrification Fields Ex | # Lines Ex | Linear Ft: Ex

Trench Width Ex | Max. Trench Bottom Depth Ex | Gravel Depth Ex

☐ New System ☐ Repair ☐ Expansion System Type: I ☒ II III IV V VI

System Description: Existing

Repair System Description:

Maintenance Agreement Required: ☐ YES ☒ NO

☒ GRAVITY ☐ PRESSURE

☒ Residence | No. Bedrooms 2

☐ Business | No. Persons 4

☐ Other | No. Employees


☐ Slab | ☒ Crawl Space

☐ Basement w/plumbing | ☐ Basement w/o plumbing


Water Supply: ☐ Private ☒ Public ☐ Community

Comments / Conditions: All building foundations must be 55' from any part of STS

INITIAL SITE SKETCH

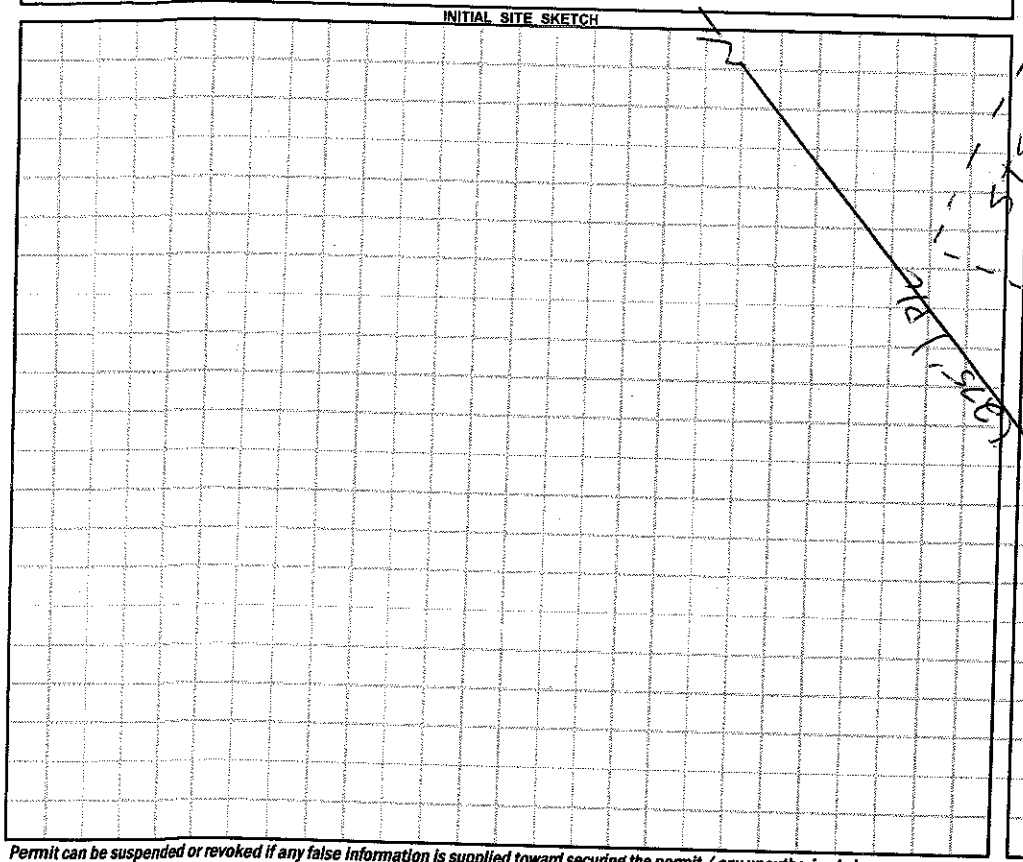

AS BUILT SKETCH

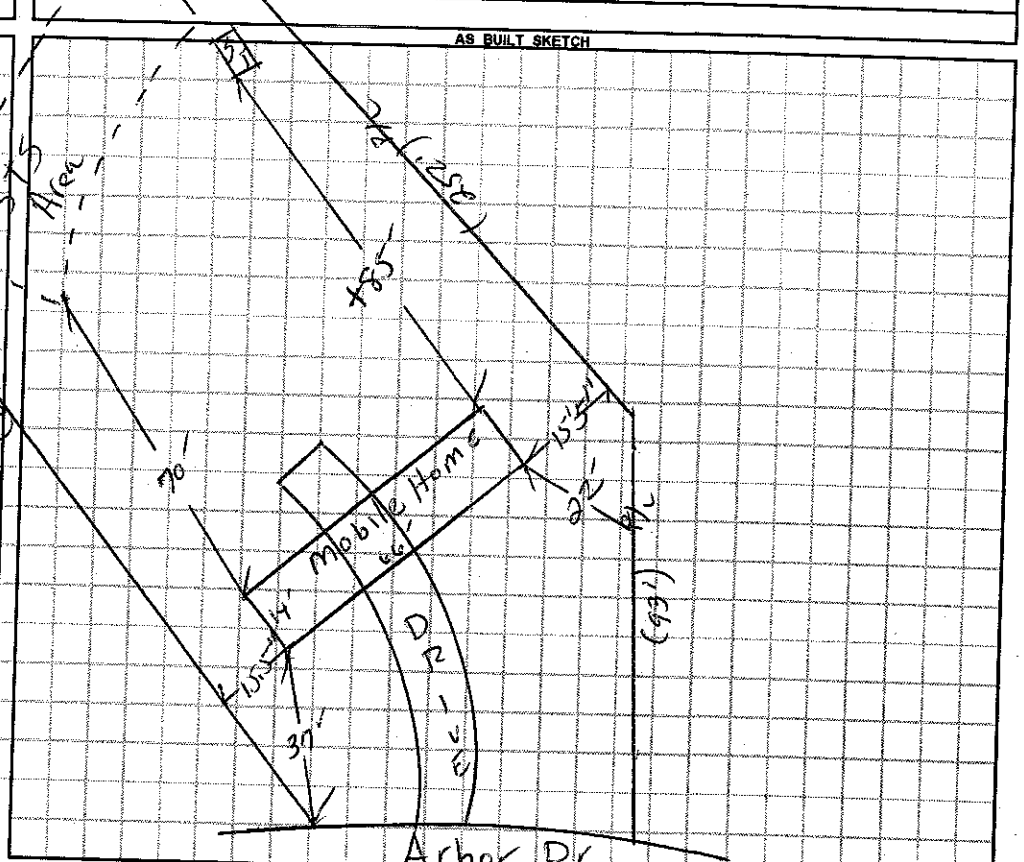

Permit can be suspended or revoked if any false information is supplied toward securing the permit / any unauthorized changes are made to the site / any unauthorized changes are made in the installation of the system. **CONTACT A LOCATOR SERVICE PRIOR TO ANY EXCAVATION**

☐ **IMPROVEMENT PERMIT** *with plat valid without expiration.* ☐ **IMPROVEMENT PERMIT** *with site plan valid for 60 mos.* ☐ **AUTHORIZATION TO CONSTRUCT** *valid for period equal to IMPROVEMENT PERMIT--not to exceed 60 mo.*

Owner / Applicant Signature: James Pearson Date: 1-27-15 Installed by:

IMPROVEMENT PERMIT by: Date: OPERATION PERMIT by: Date:

AUTHORIZATION TO CONSTRUCT by: Date: Existing System Inspected by: Date: 01/26/15

Health Dept. Copy - WHITE Applicant (Final Approval) - YELLOW Applicant (Conditional Approval) - PINK