IREDELL COUNTY HEALTH DEPARTMENT

STATESVILLE 704-878-5305 . MOORESVILLE 704-664-5281

IMPROVEMENT PERMIT / AUTHORIZATION TO CONSTRUCT / OPERATION PERMIT / EXISTING SYSTEM INSPECTION

PERMIT # 163551 PIN # 4763 61 0464 DATE 11/2/10

OWNER or APPLICANT Chris Cloninger PHONE: Business 704-437-0546 Home: 704 873-5836

OWNER or APPLICANT ADDRESS 144 Arbor Drive

LOCATION / DIRECTIONS 70E, (R) Bethesda, (L) Tree Line, (R) Arbor, site on left

SUBDIVISION Forest Acres BLOCK / SECTION n/a LOT # 165 LOT AREA _____ DESIGN FLOW 240 L.T.A.R. Ex

Septic Tank Ex. Gallons: STB _____ Date _____

Pump Tank _____ Gallons: P T _____ Date _____

Pump Make _____ Model _____ Serial # _____

Nitrification Field No Fields 1 No Lines 4 Linear Feet 267

Trench Width 36" Max. Trench Bottom Depth Ex Gravel Depth Ex

☐ New System ☐ Repair ☐ Expansion System Type I (II) III IV V VI

System Description: Existing Conv. Gravity

Repair System Description: _____

Maintenance Agreement Required ☐ YES ☒ NO

☒ GRAVITY ☐ PRESSURE

☒ Residence No. Bedrooms 2

☐ Business No. Persons _____

☐ Other No. Employees _____

☐ Slab ☒ Crawl Space


☐ Basement w/plumbing ☐ Basement w/o plumbing

Water Supply: ☐ Private ☒ Public ☐ Community


Comments / Conditions

Comments / Conditions

INITIAL SITE SKETCH

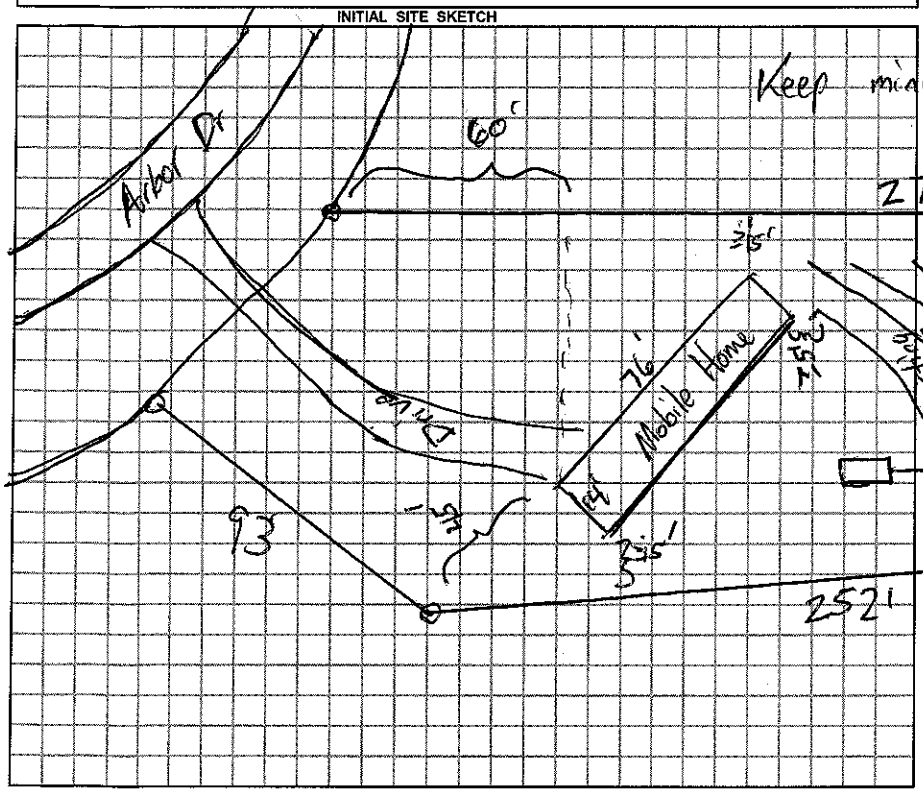

AS BUILT SKETCH

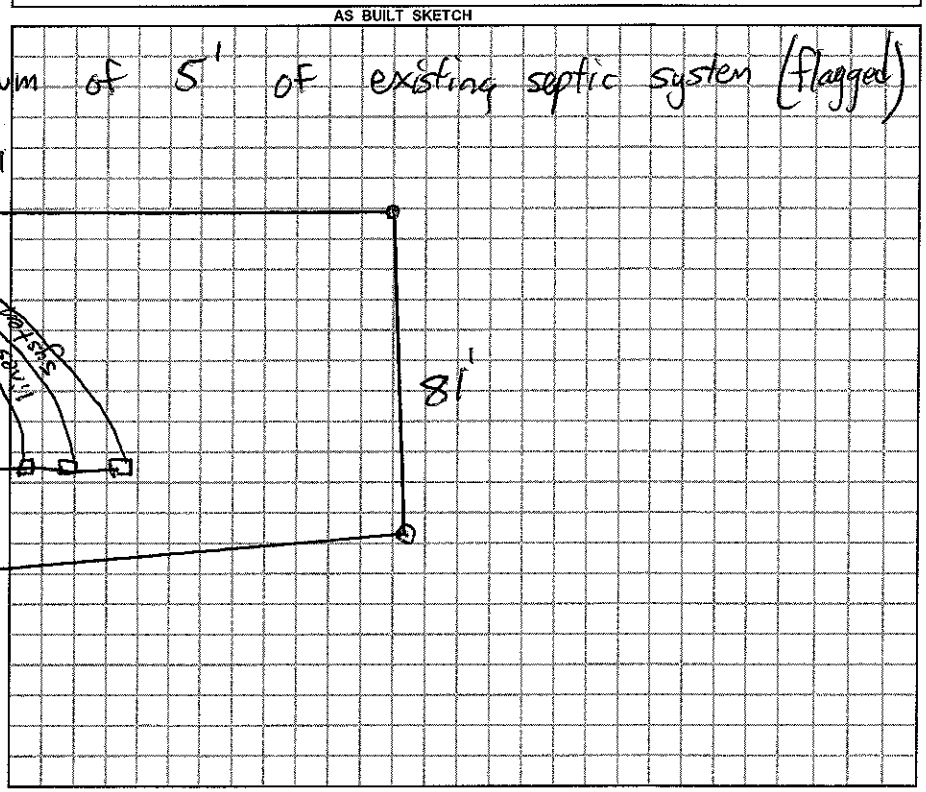

Permit can be suspended or revoked if any false information is supplied toward securing the permit / any unauthorized changes are made to the site / any unauthorized changes are made in the installation of the system.

☐ *IMPROVEMENT PERMIT w / plat valid without expiration.* ☐ *IMPROVEMENT PERMIT w / site plan valid for 60 mos.* ☐ *AUTHORIZATION TO CONSTRUCT valid for period equal to IMPROVEMENT PERMIT-not to exceed 60 mo.*

Owner / Applicant Signature: Mary Kennaiger Date 11/2/10

Improvement Permit by: _____ Date _____

Authorization to Construct by: _____ Date _____

YOU SHOULD CONTACT A LOCATOR SERVICE PRIOR TO ANY EXCAVATION.

Installed by: _____

Operation Permit by: _____ Date: _____

Existing System Inspected by: _____ Date: 11-2-10

WHITE COPY Environmental Health YELLOW COPY (Final) Owner / Applicant PINK COPY (Initial) Owner / Applicant