IREDELL COUNTY HEALTH DEPARTMENT

STATESVILLE 704-878-5305 MOORESVILLE 704-664-5281

IMPROVEMENT PERMIT / AUTHORIZATION TO CONSTRUCT / OPERATION PERMIT / EXISTING SYSTEM INSPECTION

PERMIT # 161206 PIN # 4763-61-1462 DATE 6-11-10

OWNER or APPLICANT Freedom Homes (KENNETH BOWDEN) PHONE: Business 704 746 4778 Home:

OWNER or APPLICANT ADDRESS 146 ~~Arbor Dr~~ ARBOR DR

LOCATION / DIRECTIONS Hwy 70 E to (R) on Bethesda, (L) on Treeline Dr, (R) on Arbor Dr. Lot on Right

SUBDIVISION Wayside Estates / Forest Acres BLOCK / SECTION LOT # 164 LOT AREA .54 DESIGN FLOW 360 L.T.A.R. EX

Septic Tank 1000 Gallons: STB Date EX

Pump Tank Gallons: P T Date

Pump Make Model Serial #

Nitrification Field No Fields Ex No Lines Ex Linear Feet Ex

Trench Width Ex Max. Trench Bottom Depth Ex Gravel Depth Ex

☐ New System ☐ Repair ☐ Expansion System Type I II (III) IV V VI

System Description: Existing T+J Panel

Repair System Description:

Maintenance Agreement Required ☐ YES ☒ NO

☒ GRAVITY ☐ PRESSURE


☒ Residence No. Bedrooms 3 ☐ Business No. Persons ☐ Other No. Employees ☐ Slab ☒ Crawl Space ☐ Basement w/plumbing ☐ Basement w/o plumbing

Water Supply: ☐ Private ☒ Public ☐ Community


Comments / Conditions

Comments / Conditions

INITIAL SITE SKETCH

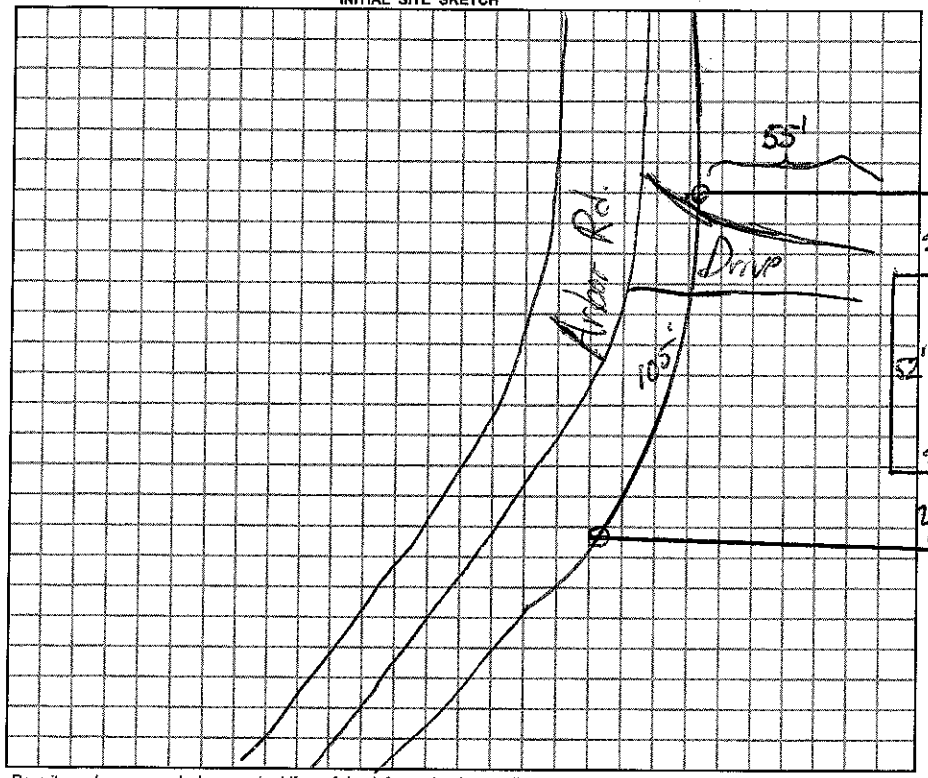

AS BUILT SKETCH

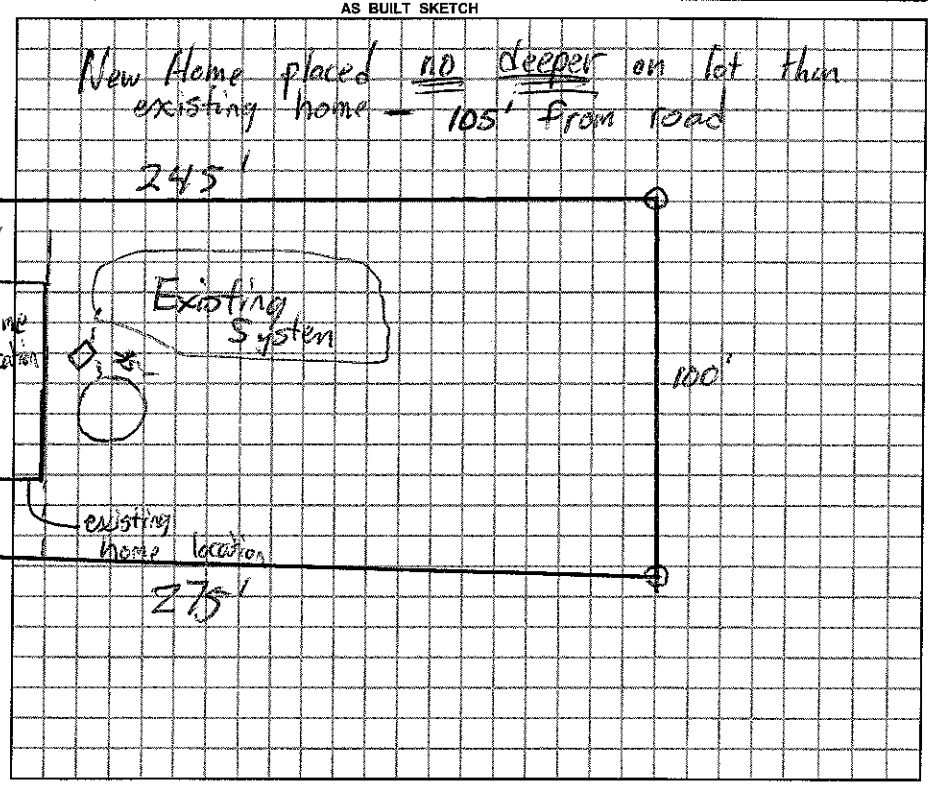

Permit can be suspended or revoked if any false information is supplied toward securing the permit / any unauthorized changes are made to the site / any unauthorized changes are made in the installation of the system.

☐ *IMPROVEMENT PERMIT w / plat valid without expiration.* ☐ *IMPROVEMENT PERMIT w / site plan valid for 60 mos.* ☐ *AUTHORIZATION TO CONSTRUCT valid for period equal to IMPROVEMENT PERMIT-not to exceed 60 mo.*

Owner / Applicant Signature: _____ Date _____

Improvement Permit by: _____ Date _____

Authorzation to Construct by: _____ Date _____

YOU SHOULD CONTACT A LOCATOR SERVICE PRIOR TO ANY EXCAVATION.

Installed by: _____

Operation Permit by: _____ Date: _____

Existing System Inspected by: James [signature] Date: 6-11-10

WHITE COPY Environmental Health YELLOW COPY (Final) Owner / Applicant PINK COPY (Initial) Owner / Applicant