IREDELL COUNTY HEALTH DEPARTMENT

STATESVILLE 704-878-5305 MOORESVILLE 704-664-5281

IMPROVEMENT PERMIT / AUTHORIZATION TO CONSTRUCT / OPERATION PERMIT / EXISTING SYSTEM INSPECTION

PERMIT# 109994 PIN# 4763-61-1695 DATE 11/22/02

OWNER OR CONTRACTOR DAVID SHOOK PHONE: Business _____ Home 704-878-6214

ADDRESS 135 ARBOR DRIVE STATESVILLE, NC 28677

LOCATION HWY 70 EAST, (R) BETHESDA RD., (L) TREE LINE RD., @ END OF TREE LINE, STRAIGHT ACROSS TO RIGHT.

SUBDIVISION FOREST ACRES BLOCK / SECTION _____ LOT 129 LOT AREA _____ SITE CLASS. PS DESIGN FLOW 360GPD L.T.A.R. 0.30 GPD/FT²

Septic Tank: 1,000 Gallons; STB 825 Date 06/07/02

Pump Tank: _____ Gallons; PT _____ Date _____

Pump Make: _____ Model _____ Serial No. _____

Nitrification Field: No. Fields 1 Square Feet EQ to 1,200 Linear Feet 200

No Lines 4@50' Trench Width 24" Max Trench Bottom Depth 36" Gravel Depth N/A

[X] New System [ ] Repair System Type: I, II, (III), IV, V, VI

System Description: 50% REDUCTION, GRAVITY

Repair System Description: 50% REDUCTION, LOW PRESSURE

Maintenance Agreement Required: [ ] Yes [X] No

[ ] House/Mod. Home [X] Mobile Home [ ] Business [ ] Other

No. Bedrooms 3 No. Bathrooms 2 No. Employees ____


[ ] Slab [X] Crawl Space [ ] Basement w/plumbing [ ] Basement wo/plumbing

Water Supply: [ ] Individual [X] Public [ ] Community


Comments/Conditions: (1) INSTALL SYSTEMS USING 11 PANELS PER LINE (44 PANELS TOTAL) (2) MAINTAIN SETBACKS INCLUDING FRENCH DRAIN SETBACKS (10' DOWN SLOPE, 15' SIDE, 2.5' UPSLOPE) (3) INSTALL FRENCH DRAIN 48" DEEP AROUND SYSTEM

Comments/Conditions: THEN TO DAYLIGHT,
- SEPTIC TANK INSTALLED USING POLY-LOC FILTER & TANK MARKER
* SYSTEM INSTALLED DURING PERIOD OF MOIST SOIL CONDITIONS.

INITIAL SITE SKETCH

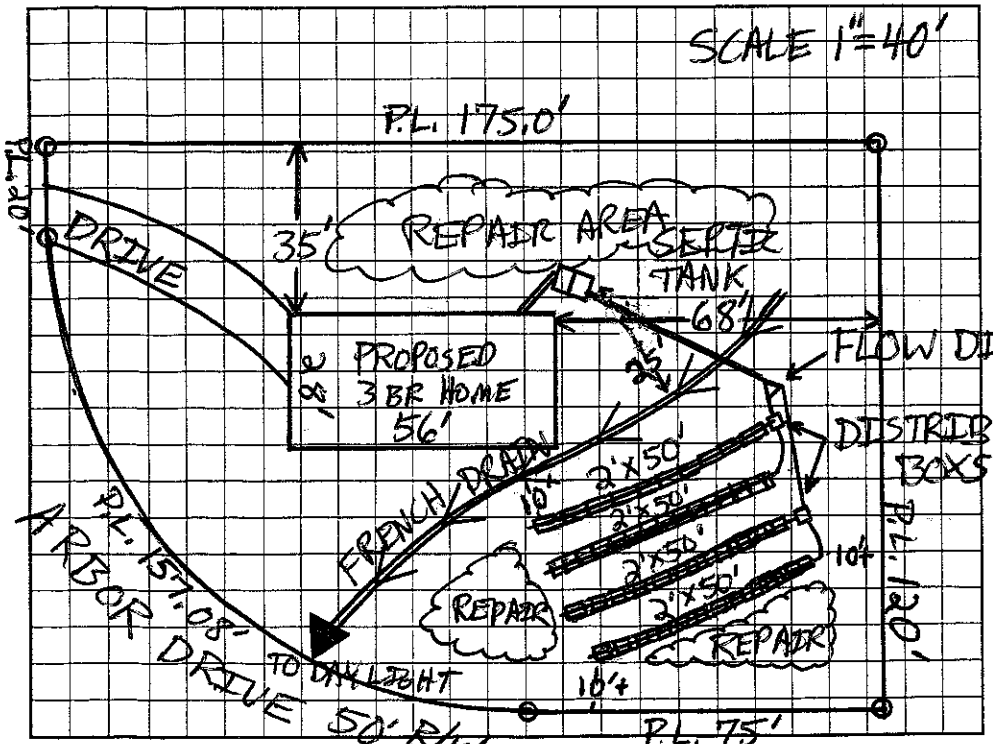

AS BUILT SKETCH

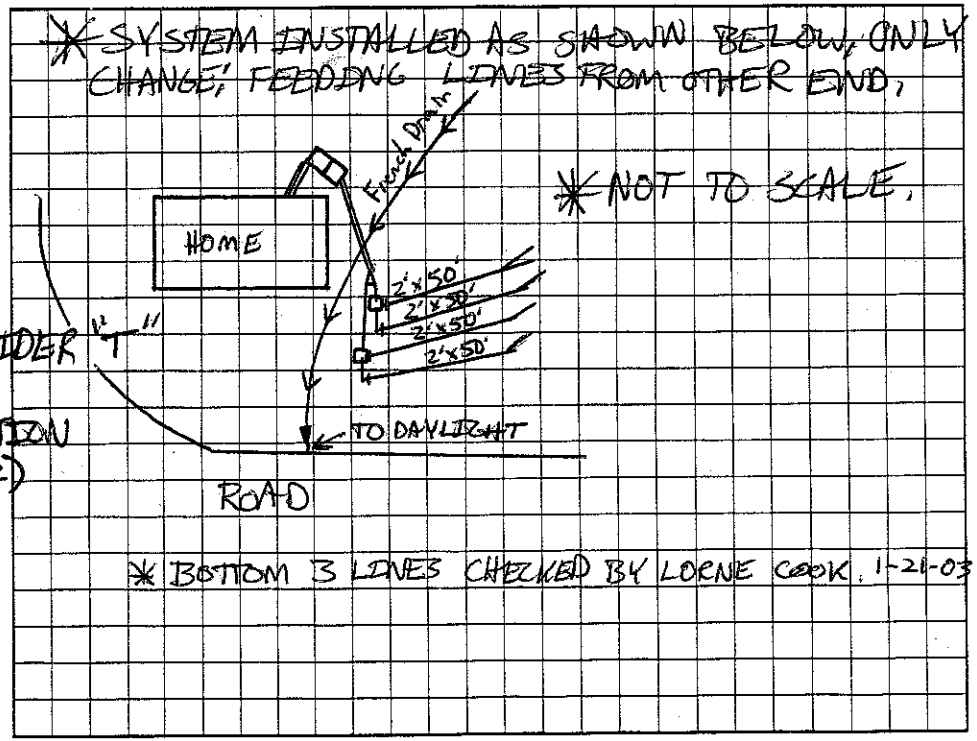

Permit can be suspended or revoked if any false information is supplied toward securing the permit/any unauthorized changes are made to the site/any unauthorized changes are made in the installation of the system. Improvement Permit with plat valid without expiration; Improvement Permit with site plan valid for sixty months. Authorization to Construct is valid for a period equal to that of Improvement Permit – not to exceed sixty months.

Signed: David W Shook date 11-22-02 Installed by: BOB'S BACKHOE 01-21-03

Improvement Permit by: Patrick Mitchell date 11/22/02 Operation Permit by: Patrick Mitchell date 01/29/03

Authorization to Construct by: Patrick Mitchell date 11/22/02 Existing System Inspection by: _____ date _____

HEALTH DEPT. COPY: WHITE OWNER COPY (FINAL): YELLOW OWNER COPY (INITIAL): PINK