IREDELL COUNTY HEALTH DEPARTMENT

STATESVILLE 704-878-5305 MOORESVILLE 704-664-5281

IMPROVEMENT PERMIT / AUTHORIZATION TO CONSTRUCT / OPERATION PERMIT / EXISTING SYSTEM INSPECTION

PERMIT# REPAIR PIN# 4763-61-2927 DATE 10-8-03

OWNER OR CONTRACTOR MICHAEL BRAGG PHONE: Business Home 704-873-0120

ADDRESS 115 ARBOR DRIVE, STATESVILLE NC 28677

LOCATION US 70 EAST, TR BETHESDA RD, TL TREELINE DR, TL ARBOR DR, 2ND LOT ON RIGHT

SUBDIVISION FOREST ACRES BLOCK / SECTION LOT 126 LOT AREA LIMITED SITE CLASS. PS DESIGN FLOW 360 L.T.A.R. EXISTING

Septic Tank: EXISTING Gallons: STB Date

Pump Tank: Gallons: PT Date

Pump Make: Model Serial No.

Nitrification Field: No Fields 1 Square Feet EQ.TO 600 Linear Feet 100

No Lines TWO Trench Width 24" Max Trench Bottom Depth 36" ~~Gravel~~ Depth SAND 24"

☐ New System ☑ Repair System Type: I, II, (III), IV, V, VI

System Description: EXPANSION

Repair System Description: 50% REDUCTION, GRAVITY

Maintenance Agreement Required: ☐ Yes ☑ No

☐ House/Mod. Home No. Bedrooms 3

☑ Mobile Home No. Bathrooms 2

☐ Business No. Employees

☐ Other FUTURE 3BR DW


☐ Slab ☑ Crawl Space ☐ Basement w/plumbing ☐ Basement wo/plumbing

Water Supply: ☐ Individual ☑ Public ☐ Community

Comments:/Conditions: (1) INSTALL NEW DISTRIBUTION BOX USING 3" SUPPLY LINES W/ SPEED LEVELERS (OR EQUIVALENT) REDUCED TO 2" AT PANELS (2) INSTALL 50% REDUCTION DRAINLINES USING 24 ARBPS PANELS IN EQUAL LENGTH LINES AS SHOWN.

Comments:/Conditions: (3) THIS PERMIT SERVES AS "NOTICE OF VIOLATION," SYSTEM TO BE REPAIRED BY 11-10-03.

INITIAL SITE SKETCH

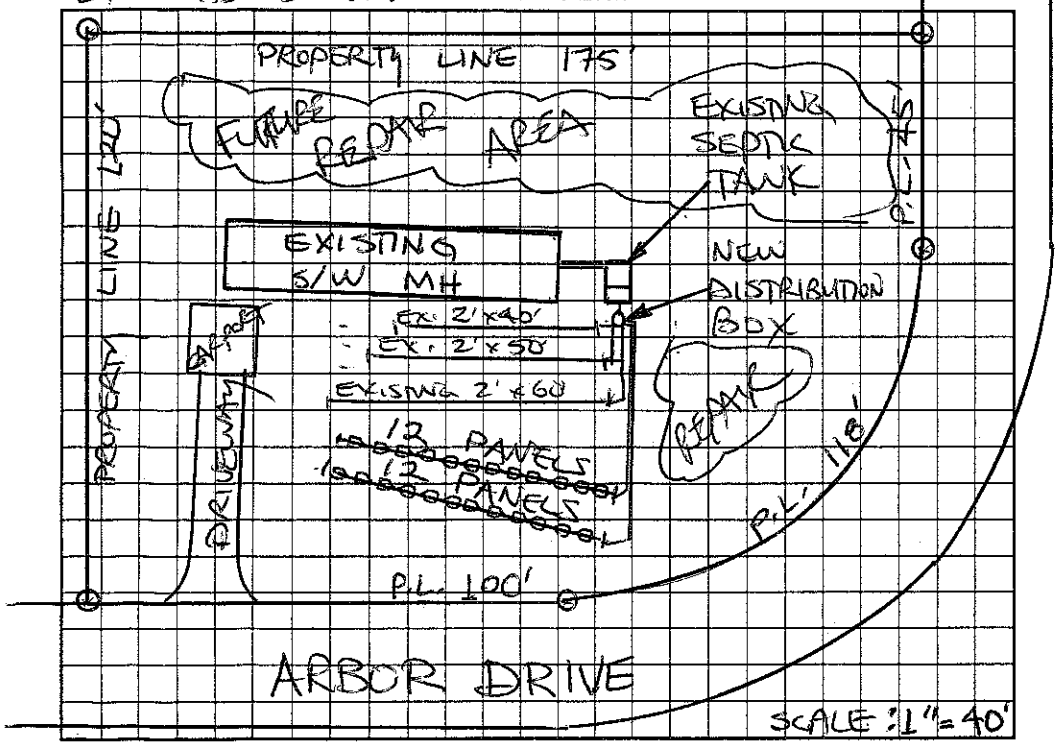

AS BUILT SKETCH

SYSTEM REPAIRED ACCORDING TO INITIAL SITE SKETCH

Permit can be suspended or revoked if any false information is supplied toward securing the permit/any unauthorized changes are made to the site/any unauthorized changes are made in the installation of the system. Improvement Permit with plat valid without expiration. Improvement Permit with site plan valid for sixty months. Authorization to Construct is valid for a period equal to that of Improvement Permit – not to exceed sixty months.

Signed: T Michael Bragg date 10-8-03 Installed by: A-1 BACKHOE

Improvement Permit by: STEVE HEARICK date 10-8-03 Operation Permit by: STEVE HEARICK date 11-13-03

Authorization to Construct by: STEVE HEARICK date 10-8-03 Existing System Inspection by: date

HEALTH DEPT. COPY: WHITE OWNER COPY (FINAL): YELLOW OWNER COPY (INITIAL): PINK

IREDELL COUNTY HEALTH DEPARTMENT

STATESVILLE 704-878-5305 MOORESVILLE 704-664-5281

IMPROVEMENT PERMIT / AUTHORIZATION TO CONSTRUCT / OPERATION PERMIT / EXISTING SYSTEM INSPECTION

PERMIT# REPAIR PIN# 4763-61-2927 DATE 10-8-03

OWNER OR CONTRACTOR MICHAEL BRAGG PHONE: Business Home 704-873-0120

ADDRESS 115 ARBOR DRIVE STATESVILLE NC 28677

LOCATION US 70 EAST, TR BETHESDA RD, TL TREELINE DR, TL ARBOR DR, 2ND LOT ON RIGHT

SUBDIVISION FOREST ACRES BLOCK / SECTION LOT 126 LOT AREA LIMITED SITE CLASS. PS DESIGN FLOW 360 L.T.A.R. EXISTING

Septic Tank: EXISTING Gallons: STB Date

Pump Tank: Gallons: PT Date

Pump Make: Model Serial No.

Nitrification Field: No Fields 1 Square Feet EQ TO 600 Linear Feet 100

No Lines TWO Trench Width 24" Max Trench Bottom Depth 36" ~~Gravel~~ Depth SAME 24"

☐ New System ☑ Repair System Type: I, II, III, IV, V, VI

System Description: EXPANSION?

Repair System Description: 50% REDUCTION, GRAVITY

Maintenance Agreement Required: ☐ Yes ☑ No

☐ House/Mod. Home No. Bedrooms 3

☐ Mobile Home No. Bathrooms 2

☐ Business No. Employees

☐ Other FUTURE 3BR DW


☐ Slab ☑ Crawl Space ☐ Basement w/plumbing ☐ Basement wo/plumbing

Water Supply: ☐ Individual ☑ Public ☐ Community

Comments/Conditions: (2) INSTALL NEW DISTRIBUTION BOX USING 3" SUPPLY LINES W/ SPEED LEVELERS (OR EQUIVALENT) REDUCED TO 2" AT PANELS @ INSTALL 50% REDUCTION DRAINLINES USING 24 ARBOS PANELS IN EQUAL LENGTH LINES AS SHOWN.

Comments/Conditions: (3) THIS PERMIT SERVES AS "NOTICE OF VIOLATION," SYSTEM TO BE REPAIRED BY 11-10-03.

INITIAL SITE SKETCH

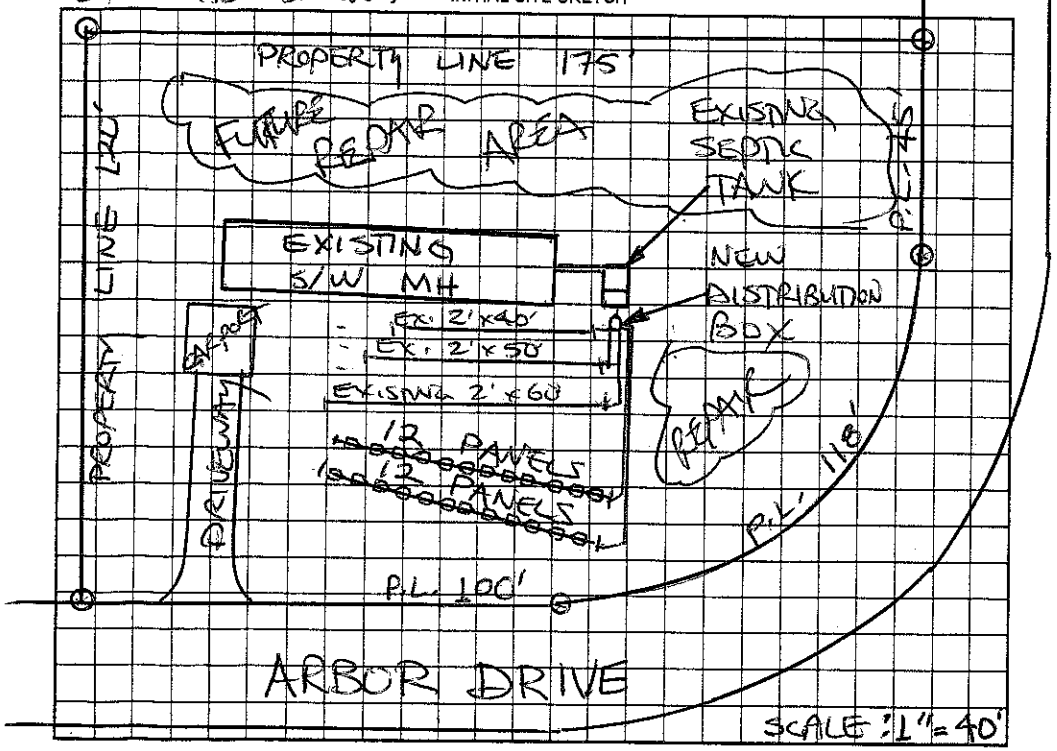

AS BUILT SKETCH

SYSTEM REPAIRED ACCORDING TO INITAL SITE SKETCH

Permit can be suspended or revoked if any false information is supplied toward securing the permit/any unauthorized changes are made to the site/any unauthorized changes are made in the installation of the system. Improvement Permit with plat valid without expiration. Improvement Permit with site plan valid for sixty months. Authorization to Construct is valid for a period equal to that of Improvement Permit – not to exceed sixty months.

Signed: † Michael Bragg date 10-8-03 Installed by: A-1 BACKHOE

Improvement Permit by: STEVE HEARICK date 10-8-03 Operation Permit by: STEVE HEARICK date 11-13-03

Authorization to Construct by: STEVE HEARICK date 10-8-03 Existing System Inspection by: date

HEALTH DEPT. COPY: WHITE OWNER COPY (FINAL): YELLOW OWNER COPY (INITIAL): PINK