CI

IREDELL COUNTY HEALTH DEPARTMENT

STATESVILLE 704-878-5305 MOORESVILLE 704-664-5281

IMPROVEMENT PERMIT / AUTHORIZATION TO CONSTRUCT / OPERATION PERMIT / EXISTING SYSTEM INSPECTION

PERMIT# 102380 PIN# 4763 61 3450 DATE 9-19-01

OWNER OR CONTRACTOR SIDNEY DAVIS PHONE: Business 704-873-2866 Home

ADDRESS 154 ARBOR RD STATESVILLE NC 28677

LOCATION BETHESDA, (L) TREELINE, (R) ARBOR 1/8 mile on right

SUBDIVISION FOREST ACRES BLOCK / SECTION LOT 157 LOT AREA 1/2 ACRE SITE CLASS IS DESIGN FLOW 360 L.T.A.R. (A) .4

Septic Tank: EXISTING Gallons: STB Date

Pump Tank: Gallons: PT Date

Pump Make: Model Serial No.

Nitrification Field: No Fields 1 Square Feet Linear Feet ~~NOW~~ 145'

No Lines 2 Trench Width 36" Max Trench Bottom Depth 36"

[X] New System [ ] Repair System Type: I, II, III, IV, V, VI

System Description: CONV GRAV

Repair System Description: LP PANEL

Maintenance Agreement Required: [ ] Yes [X] No

Gravel Depth 12"

[ ] House/Mod. Home No. Bedrooms 3

[X] Mobile Home No. Bathrooms 2

[ ] Business No. Employees

[ ] Other


[ ] Slab [X] Crawl Space [ ] Basement w/plumbing [ ] Basement wo/plumbing

Water Supply: [ ] Individual [X] Public [ ] Community

Comments/Conditions: (1) NEW D/W BACK SHOULD BE AT SAME LOCATION OF SINGLE WIDE BACK (2) INSTALL TWO NEW LINES ON DROP BOXES LEAVING AS MUCH REPAIR AS POSSIBLE

Comments/Conditions: (3) 176' IS OVERKILL BUT GET AS MUCH AS POSSIBLE IN THE TWO LINES


INITIAL SITE SKETCH

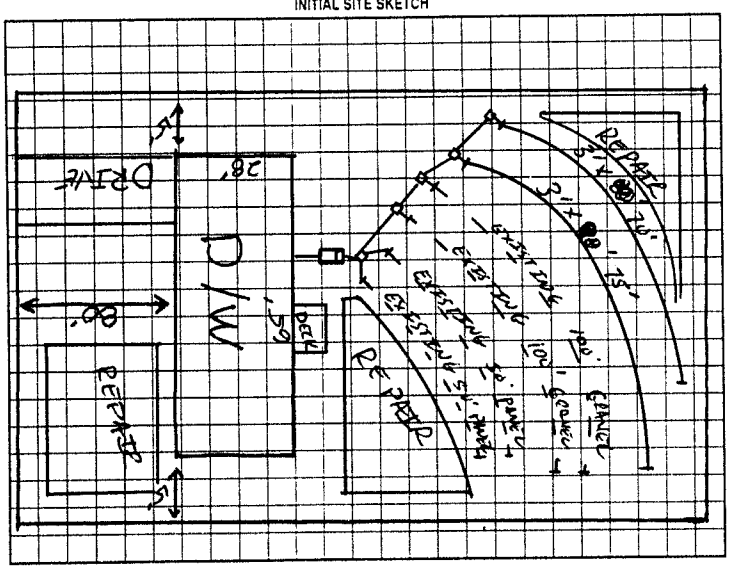

AS BUILT SKETCH

ADDED EXTRA STONE TO EAKH LINE FOR INSURANCE EXTRA

TIED INTO BLACK PIPE WITH DROP BOX DUE TO LINE BEING TO CLOSE TO PROPERTY LINE

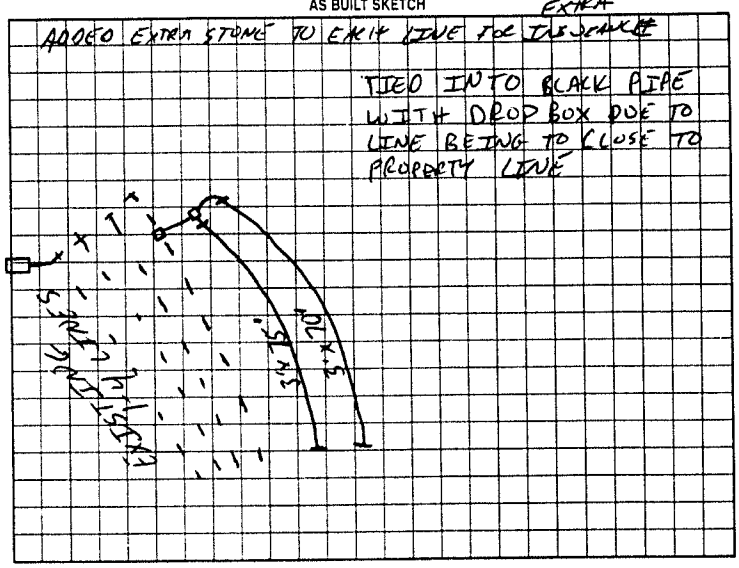

Permit can be suspended or revoked if any false information is supplied toward securing the permit/any unauthorized changes are made to the site/any unauthorized changes are made in the installation of the system. Improvement Permit with plat valid without expiration. Improvement Permit with site plan valid for sixty months. Authorization to Construct is valid for a period equal to that of Improvement Permit – not to exceed sixty months.

Signed: Bonnie O Davis date

Improvement Permit by: RS date 9-20-01

Authorization to Construct by: RS date 9-20-01

Installed by: A-1 BACKHOE

Operation Permit by: RS date 9-21-01

Existing System Inspection by: date

HEALTH DEPT COPY WHITE OWNER COPY (FINAL) YELLOW OWNER COPY (INITIAL) PINK