# IREDELL COUNTY HEALTH DEPARTMENT

STATESVILLE 704-878-5305 MOORESVILLE 704-664-5281

## IMPROVEMENT PERMIT / AUTHORIZATION TO CONSTRUCT / OPERATION PERMIT / EXISTING SYSTEM INSPECTION

PERMIT # 15794 PIN # 4763 Lot 3638 DATE 8-19-09

OWNER or APPLICANT Simon Gutierrez PHONE: Business Home: 704-796-4778

OWNER or APPLICANT ADDRESS 153 Cindy Drive Statesville

LOCATION / DIRECTIONS Bethesda TO Turnpike TO Arbor on left

SUBDIVISION Forest Acres BLOCK / SECTION Rear LOT # 130 LOT AREA .47 DESIGN FLOW 360 L.T.A.R. Exist

Septic Tank Exist Gallons: STB Date

Pump Tank Gallons: P T Date

Pump Make Model Serial #

Nitrification Field No Fields No Lines 3 Linear Feet Exist 200

Trench Width Exist Max. Trench Bottom Depth Exist Gravel Depth 10"

~~New System~~ Repair Expansion System Type IV V VI

System Description: Gravel

Repair System Description: 3570 Pump - Crawl

Maintenance Agreement Required YES NO

GRAVITY PRESSURE

~~Residence~~ No. Bedrooms 3

Business No. Persons

Other No. Employees

Slab ~~Crawl~~ Space

Basement w/plumbing Basement w/o plumbing

Water Supply: Private Public Community

Comments / Conditions

Maintain all setbacks for Building Code


Comments / Conditions

At time of inspection no evidence of failure.

INITIAL SITE SKETCH

Maintain 5' away from septic

AS BUILT SKETCH

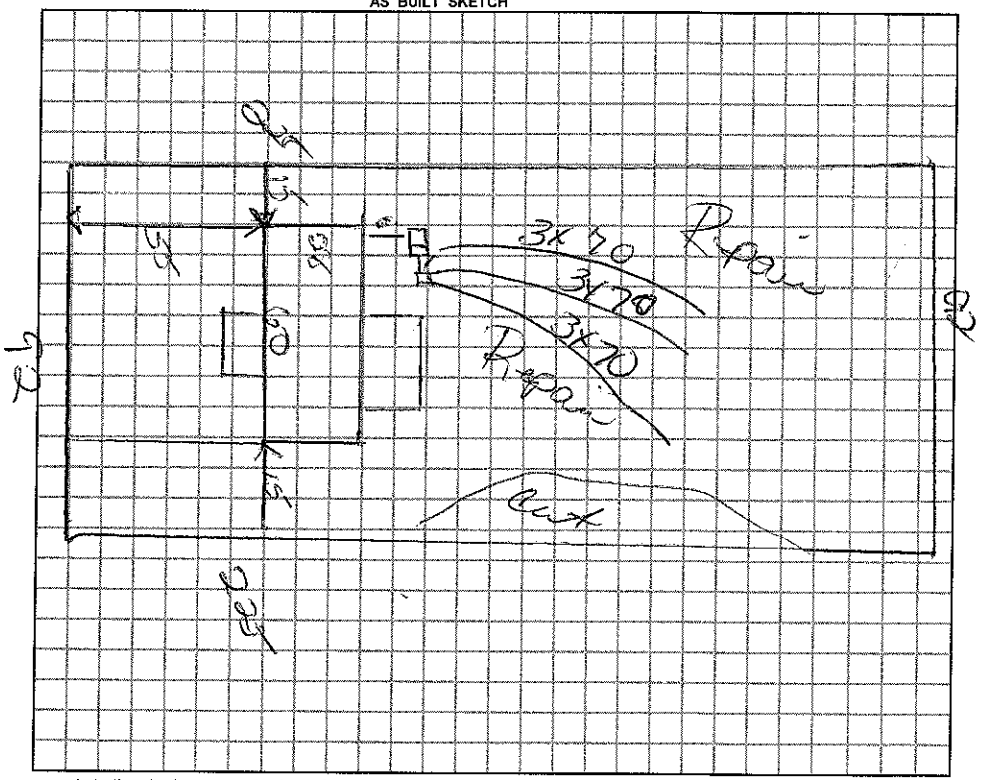


*Permit can be suspended or revoked if any false information is supplied toward securing the permit / any unauthorized changes are made to the site / any unauthorized changes are made in the installation of the system.*

☐ *IMPROVEMENT PERMIT w / plat valid without expiration.* ☐ *IMPROVEMENT PERMIT w / site plan valid for 60 mos.* ☑ *~~AUTHORIZATION~~ TO CONSTRUCT valid for period equal to IMPROVEMENT PERMIT-not to exceed 60 mo.*

Owner / Applicant Signature: _____ Date _____

Improvement Permit by: _____ Date _____

Authorization to Construct by: _____ Date _____

***YOU SHOULD CONTACT A LOCATOR SERVICE PRIOR TO ANY EXCAVATION.***

Installed by: _____

Operation Permit by: _____ Date: _____

Existing System Inspected by: Kevin Cook Date: 8-19-09

WHITE COPY Environmental Health YELLOW COPY (Final) Owner / Applicant PINK COPY (Initial) Owner / Applicant