IREDELL COUNTY HEALTH DEPARTMENT

STATESVILLE 704-878-5305 ✓ MOORESVILLE 704-664-5281

IMPROVEMENT PERMIT / AUTHORIZATION TO CONSTRUCT / OPERATION PERMIT / EXISTING SYSTEM INSPECTION

PERMIT# 105301 PIN# 4763-61-4263 DATE 6-19-02

OWNER OR CONTRACTOR TSUMAS FAMILY LTD PHONE: Business 704-878-9171 Home

ADDRESS 112 ISLAND SYCAMORE DR STATESVILLE, NC 28677

LOCATION US 70 E TR BETHESDA, TL TREELINE DR, TR ARBOR TR ISLAND SYCAMORE, 3RD LOT ON RIGHT

SUBDIVISION FOREST ACRES BLOCK / SECTION LOT 154 LOT AREA 90'x119' SITE CLASS PS DESIGN FLOW 360 L.T.A.R. 0.30 GPD/FT²

Septic Tank: EXISTING Gallons: STB Date

Pump Tank: Gallons: PT Date

Pump Make: Model Serial No.

Nitrification Field: No Fields 1 Square Feet Eq. to 600 Linear Feet 100

No Lines THREE Trench Width 24" Max Trench Bottom Depth 36" +/- Gravel Depth SAND 6"

✓ New System ☐ Repair System Type: I. II. III. IV. V. VI

System Description: 50% REDUCTION, GRAVITY

Repair System Description: 50% REDUCTION, LOW-PRESSURE

Maintenance Agreement Required: ☐ Yes ☑ No

☐ House/Mod. Home ☑ Mobile Home ☐ Business ☐ Other

No. Bedrooms 3 No. Bathrooms 2 No. Employees


Water Supply: ☐ Individual ☑ Public ☐ Community

☐ Slab ☑ Crawl Space ☐ Basement w/plumbing ☐ Basement wo/plumbing


Comments/Conditions: INSTALL 50% REDUCTION SYSTEM USING 23 PPBPS PANELS IN LINE LENGTHS AS SHOWN BELOW.

Comments/Conditions: - Installed 23 PPBPS Panels

INITIAL SITE SKETCH

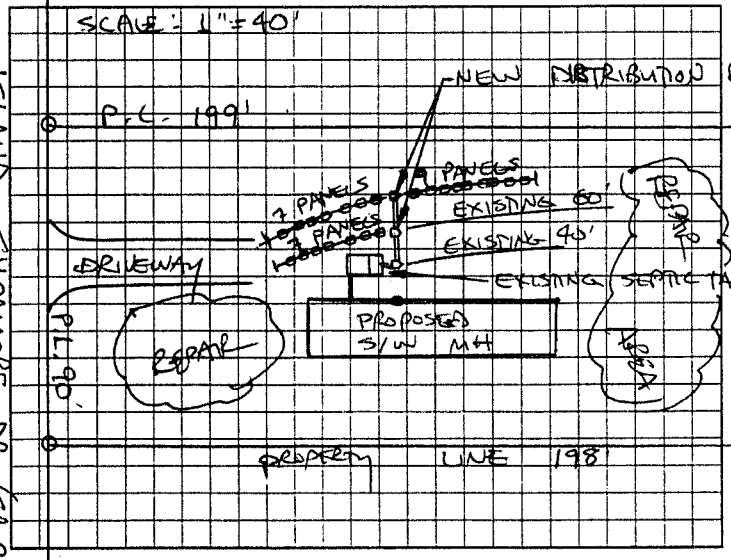

AS BUILT SKETCH

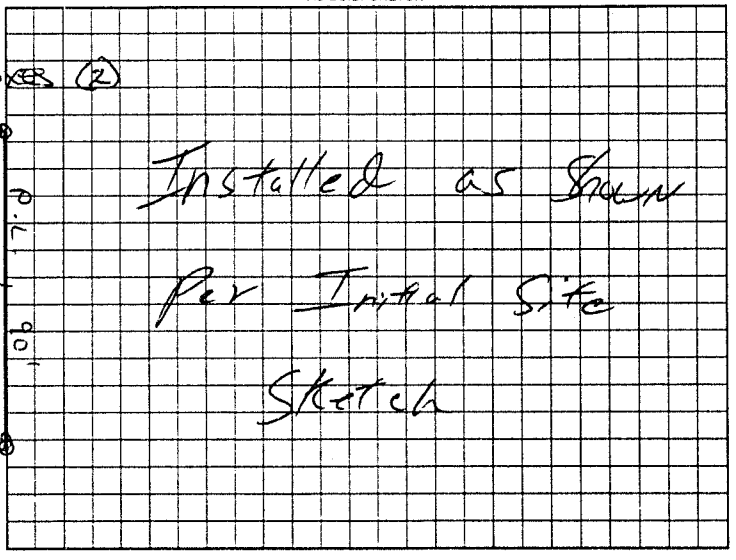

Permit can be suspended or revoked if any false information is supplied toward securing the permit/any unauthorized changes are made to the site/any unauthorized changes are made in the installation of the system. Improvement Permit with plat valid without expiration. Improvement Permit with site plan valid for sixty months. Authorization to Construct is valid for a period equal to that of Improvement Permit - not to exceed sixty months

Signed: John K Woodard date 6-20-02 Installed by Lance Logic

Improvement Permit by: STEVE HEDRICK date 6-19-02 Operation Permit by: William O. Johnson date 6/27/02

Authorization to Construct by: STEVE HEDRICK date 6-19-02 Existing System Inspection by: date

HEALTH DEPT COPY: WHITE OWNER COPY (FINAL) YELLOW OWNER COPY (INITIAL) PINK