IREDELL COUNTY HEALTH DEPARTMENT

STATESVILLE 704-878-5305 MOORESVILLE 704-664-5281

IMPROVEMENT PERMIT / AUTHORIZATION TO CONSTRUCT / OPERATION PERMIT / EXISTING SYSTEM INSPECTION

PERMIT # 158048 PIN # 4763 614374 DATE 9-15-09

OWNER or APPLICANT Melquiades Baza PHONE: Business Home: 704 746 4778

OWNER or APPLICANT ADDRESS 108 Island Sycamore Dr.

LOCATION / DIRECTIONS 70 East, (R) on Bethesda Rd, (L) on Treeline, (R) on A

SUBDIVISION Forest Acres BLOCK / SECTION LOT # 155 LOT AREA .442 DESIGN FLOW 240 L.T.A.R. EX

Septic Tank Ex Gallons: STB Ex Date Ex

Pump Tank Gallons: P T Date

Pump Make Model Serial #

Nitrification Field No Fields Ex No Lines Ex Linear Feet Ex.

Trench Width Ex Max. Trench Bottom Depth Ex. Gravel Depth Ex

☐ New System ☐ Repair ☐ Expansion System Type I II (III) IV V VI

System Description: 50% Reduction Panel

Repair System Description:

Maintenance Agreement Required ☐ YES ☐ NO

☒ GRAVITY ☐ PRESSURE

☒ Residence No. Bedrooms 2

☐ Business No. Persons

☐ Other No. Employees

☐ Slab ☒ Crawl Space


☐ Basement w/plumbing ☐ Basement w/o plumbing

Water Supply: ☐ Private ☒ Public ☐ Community

Comments / Conditions

Comments / Conditions Cannot Locate Original Permit

INITIAL SITE SKETCH

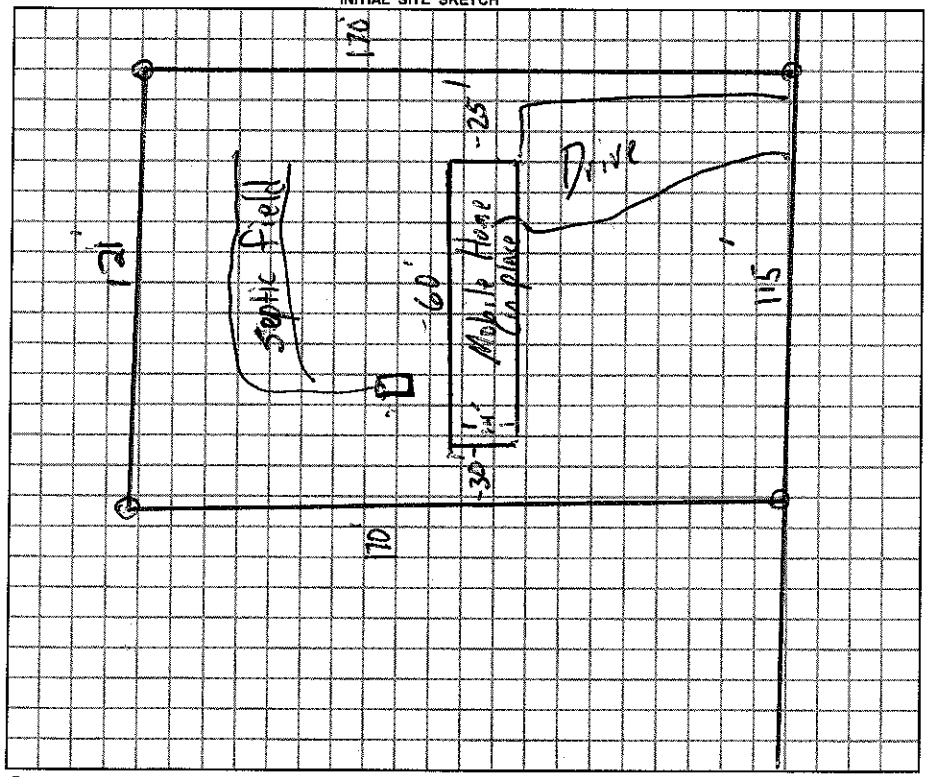

AS BUILT SKETCH

Permit can be suspended or revoked if any false information is supplied toward securing the permit / any unauthorized changes are made to the site / any unauthorized changes are made in the installation of the system.

☐ *IMPROVEMENT PERMIT w / plat valid without expiration.* ☐ *IMPROVEMENT PERMIT w / site plan valid for 60 mos.* ☐ *AUTHORIZATION TO CONSTRUCT valid for period equal to IMPROVEMENT PERMIT-not to exceed 60 mo.*

Owner / Applicant Signature: Date 9-16-09

Improvement Permit by: Date

Authorzation to Construct by: Date

YOU SHOULD CONTACT A LOCATOR SERVICE PRIOR TO ANY EXCAVATION.

Installed by:

Operation Permit by: Date:

Existing System Inspected by: Date: 9-15-09

WHITE COPY Environmental Health YELLOW COPY (Final) Owner / Applicant PINK COPY (Initial) Owner / Applicant