IREDELL COUNTY HEALTH DEPARTMENT

STATESVILLE 704-878-5305 MOORESVILLE 704-664-5281

IMPROVEMENT PERMIT / AUTHORIZATION TO CONSTRUCT / OPERATION PERMIT / EXISTING SYSTEM INSPECTION

PERMIT# 137286 PIN# 4763-61-5617 DATE 08/02/06

OWNER OR APPLICANT LINDA SMITH PHONE: Business 704-905-8540 Home

ADDRESS 631 BRAWLEY SCHL RD, MOORESVILLE, NC 28117

LOCATION HWY 70 E, (R) BETHESDA RD., (L) TREE LINE DR., (R) ARBOR DR., LOT ON LEFT. (16 ARBOR DRIVE)

SUBDIVISION FOREST ACRES BLOCK / SECTION ____ LOT 132 LOT AREA 0.47 ACRES SITE CLASS. EXIST. DESIGN FLOW 240 GPD L.T.A.R. EXIST.

EXIST.

Septic Tank: 1,000 Gallons; STB ____ Date ____

Pump Tank: ____ Gallons; PT ____ Date ____

Pump Make: ____ Model ____ Serial No. ____

Nitrification Field: No Fields 1 Square Feet ~300 Linear Feet 100'

No Lines 2@50' Trench Width ? Max Trench Bottom Depth ?

☐ New System ☐ Repair ☐ Expansion System Type: I II (III) IV V VI

System Description: GRAVITY, 50% REDUCT

Repair System Description: ____

Maintenance Agreement Required: ☐ Yes ☒ No

Gravel Depth N/A ☒ Gravity ☐ Pressure ☐ Slab ☒ Crawl Space ☐ Basement w/plumbing ☐ Basement wo/plumbing

☒ House/Mod. Home ☒ Mobile Home ☐ Business ☐ Other


No. Bedrooms 2 No. Persons ____ No. Employees ____

Water Supply: ☐ Individual ☒ Public ☐ Community


Comments:/Conditions:

Comments:/Conditions:

INITIAL SITE SKETCH

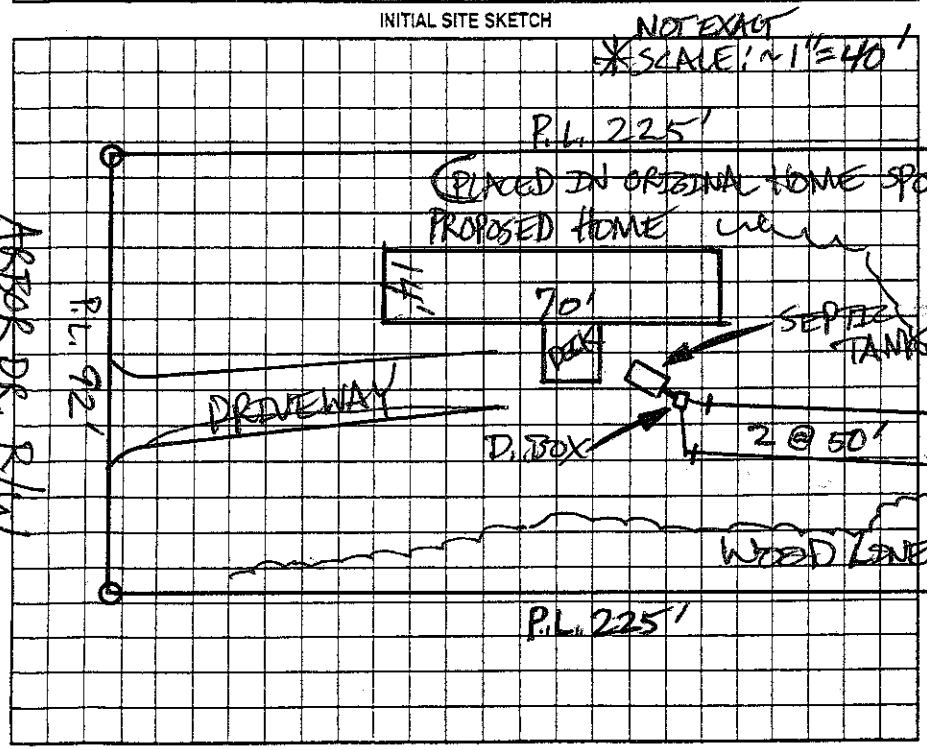

AS BUILT SKETCH

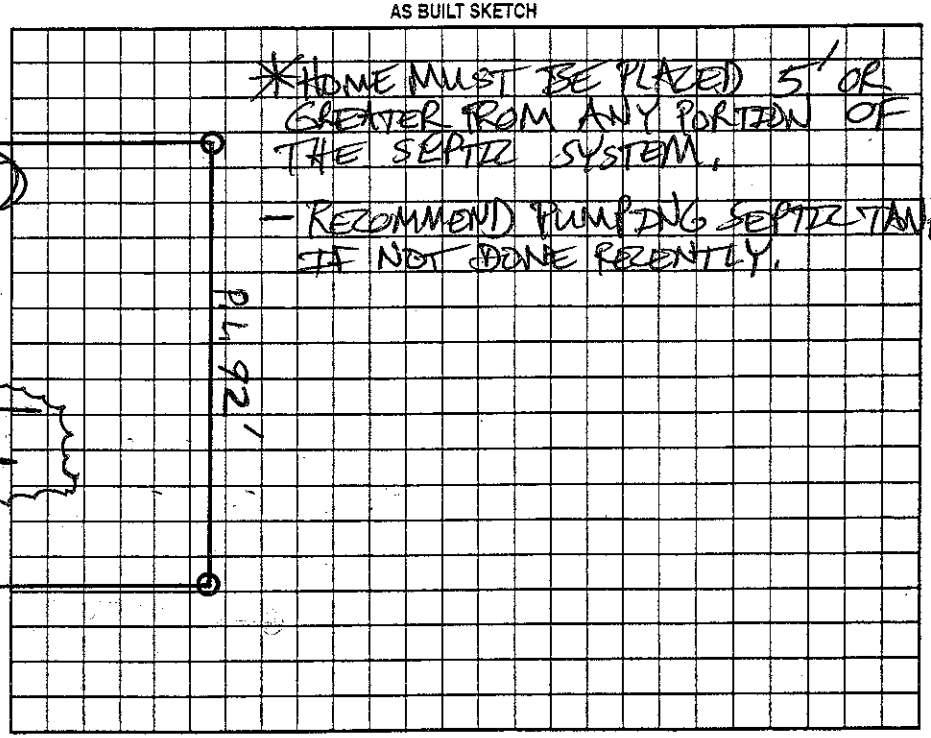

Permit can be suspended or revoked if any false information is supplied toward securing the permit/any unauthorized changes are made to the site/any unauthorized changes are made in the installation of the system. Improvement Permit with plat valid without expiration. ☐ Improvement Permit with site plan valid for sixty months ☒ Authorization to Construct is valid for a period equal to that of Improvement Permit – not to exceed sixty months.

Signed: ____ date ____

Improvement Permit by: ____ date ____

Authorization to Construct by: ____ date ____

Installed by: ____

Operation Permit by: ____ date ____

Existing System Inspection by: [signature] date 08/02/06

HEALTH DEPT. COPY: WHITE OWNER COPY (FINAL): YELLOW OWNER COPY (INITIAL): PINK