IREDELL COUNTY HEALTH DEPARTMENT

Statesville Office (704) 878-5305 Mooresville Office (704) 660-3625 PERMIT # 209076

IMPROVEMENT PERMIT / AUTHORIZATION TO CONSTRUCT / OPERATION PERMIT / EXISTING SYSTEM

PIN # 4763621474

APPLICANT: Kenneth Powers APPLICANT ADDRESS: 164 Red Oak Dr Statesville NC 28687

SITE ADDRESS: 164 Red Oak Dr Statesville NC 28687 PHONE: 704-929-0274 ALT. PHONE: N/A

SITE DIRECTIONS: Salisbury Rd to Bethesda to Red Oak Rd


SUBDIVISION: Forest Acres SECTION: #3 LOT # 93 LOT AREA: .640 ac DESIGN FLOW: 360 L.T.A.R.: Ex

Septic Tank	Ex	(gal)	STB		Date		☐ New System	☐ Repair	☐ Expansion	System Type: I II III IV V VI	☒ Residence	No. Bedrooms	3	Water Supply	
Pump Tank		(gal)	PT		Date		System Description:	Existing			☐ Business	No. Persons	6	☐ Private	
Pump Make			Model		Serial #		Repair System Description:				☐ Other	No. Employees		☐ Public	
# Nitrification Fields	EX	# Lines	Ex		Linear Ft:	Ex	Maintenance Agreement Required:	☐ YES	☒ NO		☒ Slab	☐ Crawl Space		☐ Community	
Trench Width	Ex	Max. Trench Bottom Depth	Ex		Gravel Depth	Ex		☑ GRAVITY	☐ PRESSURE		☐ Basement w/plumbing		☐ Basement w/o plumbing		

Comments / Conditions: Existing Home must be removed before C.O. is issued. Maintain 55' from any part of STS.

INITIAL SITE SKETCH

AS BUILT SKETCH

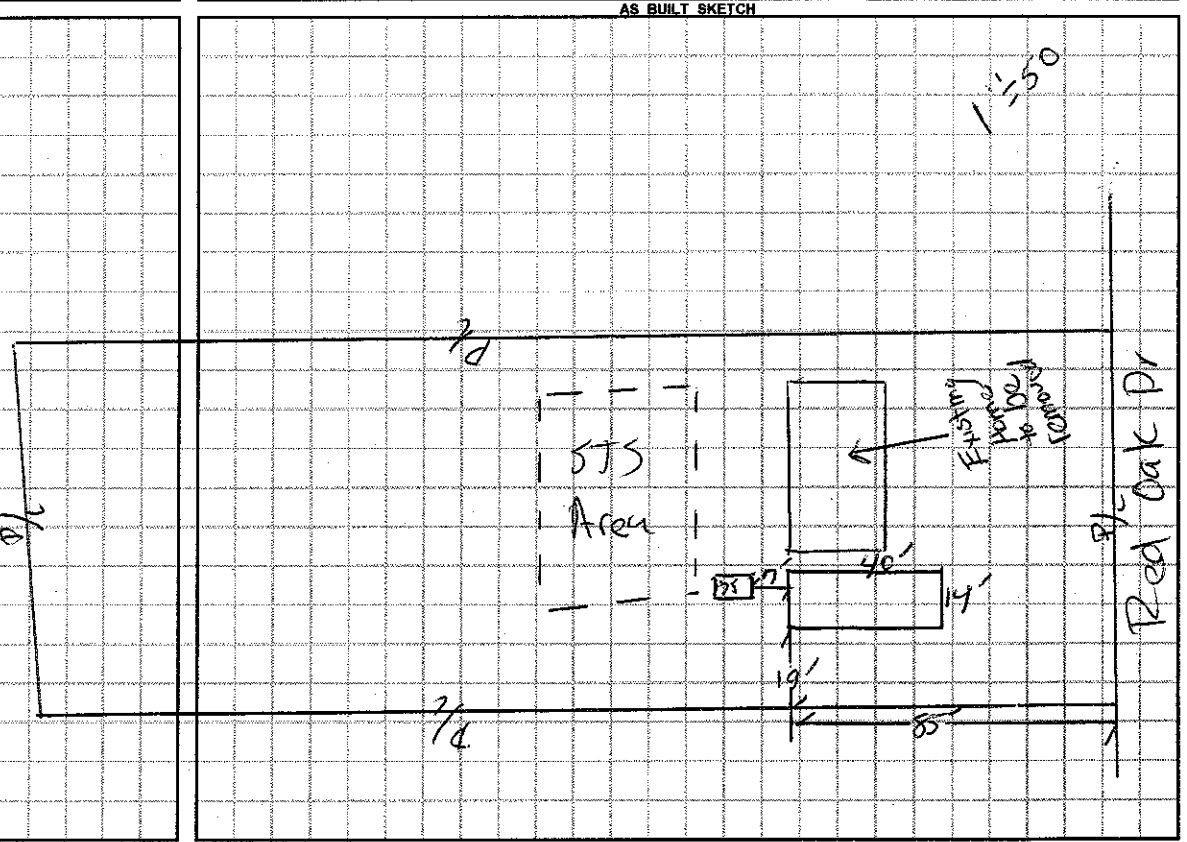

Permit can be suspended or revoked if any false information is supplied toward securing the permit / any unauthorized changes are made to the site / any unauthorized changes are made in the installation of the system. **CONTACT A LOCATOR SERVICE PRIOR TO ANY EXCAVATION**

☐ **IMPROVEMENT PERMIT** *with plat valid without expiration.* ☐ **IMPROVEMENT PERMIT** *with site plan valid for 60 mos.* ☐ **AUTHORIZATION TO CONSTRUCT** *valid for period equal to IMPROVEMENT PERMIT--not to exceed 60 mo.*

Owner / Applicant Signature: [signature] Date: 04-01-2015 Installed by:

IMPROVEMENT PERMIT by: Date: OPERATION PERMIT by: Date:

AUTHORIZATION TO CONSTRUCT by: Date: Existing System Inspected by: [signature] Date: 03/30/15

Health Dept. Copy - WHITE Applicant (Final Approval) - YELLOW Applicant (Conditional Approval) - PINK