IREDELL COUNTY HEALTH DEPARTMENT

STATESVILLE 704-878-5305 MOORESVILLE 704-664-5281

(1)

IMPROVEMENT PERMIT / AUTHORIZATION TO CONSTRUCT / OPERATION PERMIT / EXISTING SYSTEM INSPECTION

PERMIT# 134694 PIN# 4763-62-5139 DATE 4-10-06

OWNER OR CONTRACTOR DAVID BLAKLEY PHONE: Business 704-252-0252 Home

ADDRESS 100 ARBOR DR, STATESVILLE NC

LOCATION US 70 EAST, TR BETHESDA ROAD, TL TREELINE DR, TL ARBOR DRIVE, AT END ON LEFT

SUBDIVISION FOREST ACRES BLOCK / SECTION LOT 121 LOT AREA ~1 ACRE SITE CLASS. PS DESIGN FLOW 360 L.T.A.R. EXISTING 0.4 GPD/FT²

Septic Tank: 1000 Gallons; STB Date

Pump Tank: Gallons; PT Date

Pump Make: Model Serial No.

Nitrification Field: No Fields 1 Square Feet EQUIV Linear Feet 150

No Lines TWO Trench Width 24" Max Trench Bottom Depth 36" Gravel Depth SAND

☒ New System ☐ Repair System Type: I II III IV V VI

System Description: 50% REDUCTION, GRAVITY

Repair System Description:

Maintenance Agreement Required: ☐ Yes ☐ No

☐ House/Mod. Home No. Bedrooms 3

☒ Mobile Home No. Bathrooms

☐ Business No. Employees

☐ Other

☐ Slab ☐ Crawl Space ☐ Basement w/plumbing ☐ Basement wo/plumbing


Water Supply: ☐ Individual ☒ Public ☐ Community

Comments:/Conditions:

Comments:/Conditions: SYSTEM INSTALLED OUT OF CONTOUR IN TWO 75' PPBPS LINES. NO SIGN of MALFUNCTION AT TIME of INSPECTION

INITIAL SITE SKETCH

AS BUILT SKETCH

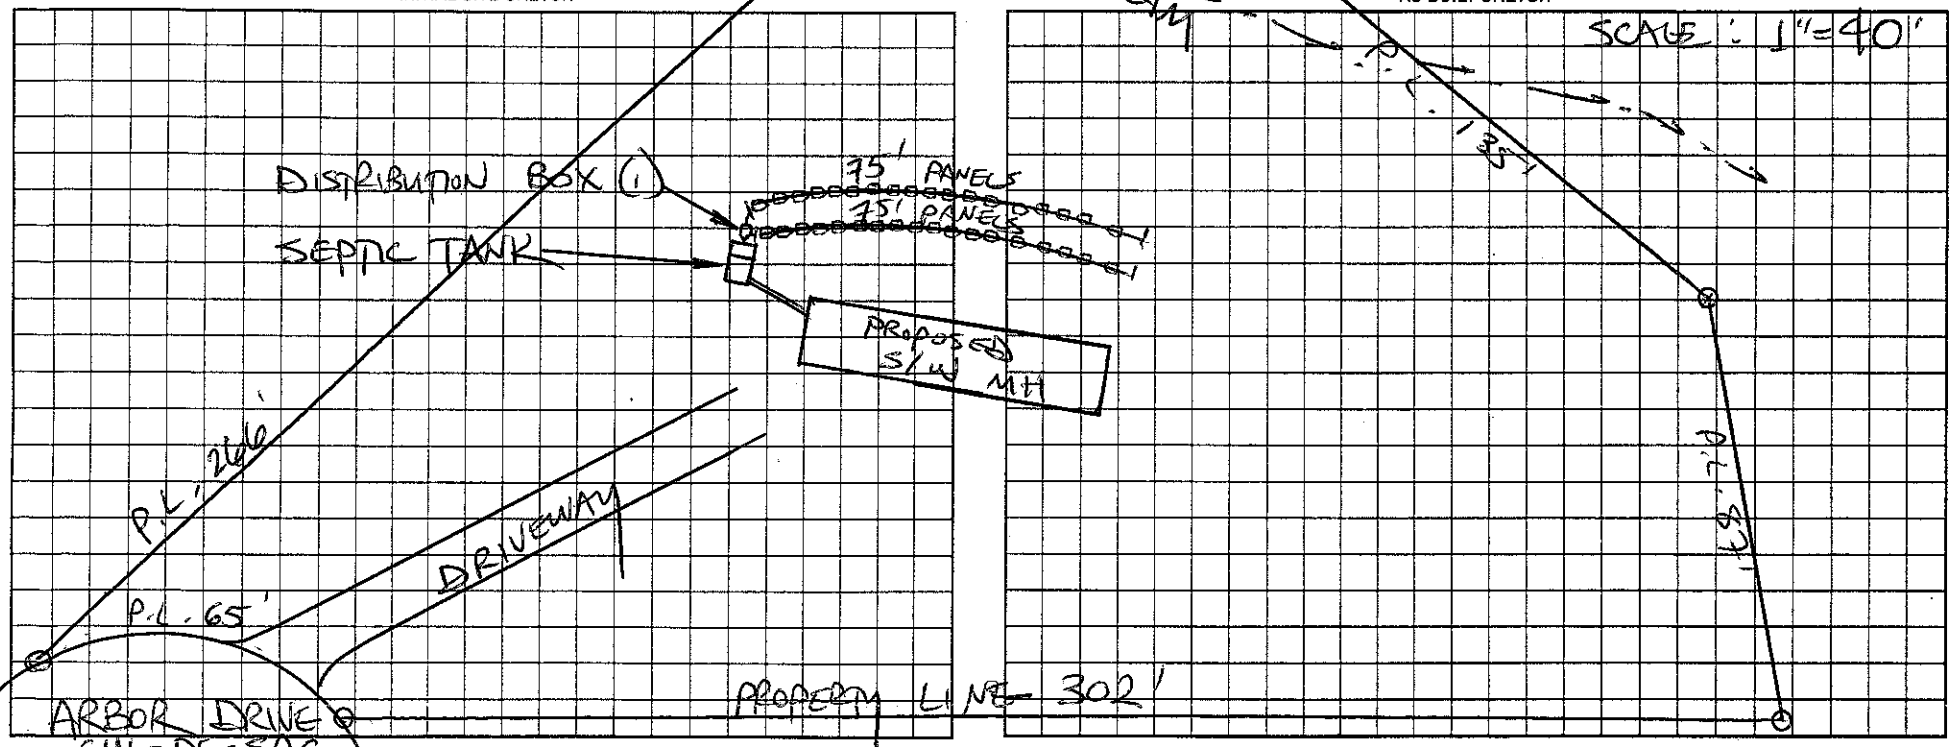

Permit can be suspended or revoked if any false information is supplied toward securing the permit/any unauthorized changes are made to the site/any unauthorized changes are made in the installation of the system. Improvement Permit with plat valid without expiration. Improvement Permit with site plan valid for sixty months. Authorization to Construct is valid for a period equal to that of Improvement Permit – not to exceed sixty months.

Signed: date Installed by:

Improvement Permit by: date Operation Permit by: date

Authorization to Construct by: date Existing System Inspection by: STEVE HENDRICK date 4-10-06

HEALTH DEPT. COPY: WHITE OWNER COPY (FINAL): YELLOW OWNER COPY (INITIAL): PINK